


Survey made in Section 26 Town-
 ship 5 North of Range 5 West 1854 by
 G. M. Hayden Deputy County Surveyor of the West
 1/2 of the N.W. 1/4 for Russell Brooks, of the N.W. 1/4 of
 S.W. 1/4 for Byron Henderson - The S.E. 1/4 of N.W. 1/4
 N.E. 1/4 of S.W. 1/4 for Benjamin Cooper - The N.E. 1/4
 of N.W. 1/4 for Buchanan and S 1/4 of S.W. 1/4 for
 George Morris.


Section 26 Township 5 North Range 5 West.

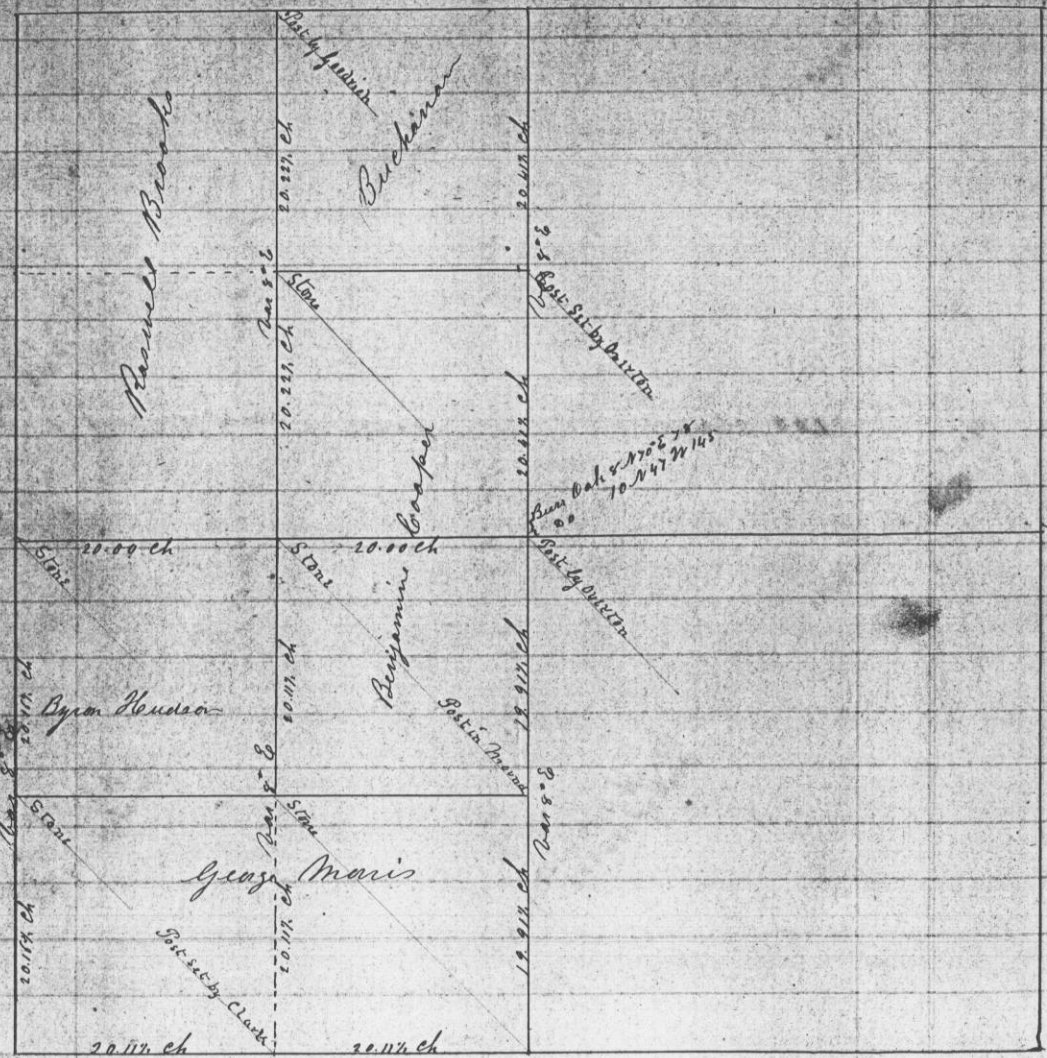

A true copy of the original notes and plat
 of said survey
 Witness October 20 1854
 John G. Clark
 County Surveyor

Survey made June 15th 1854 by G. M. Hayden Deputy
 County Surveyor for G. C. Bucknell of the N.W. 1/4 of S.W. 1/4 of
 Section 27 Township 4 North Range 5 West. William Greenleaf and
 Newton Louane Chaimmen.

Section 27 Township 4 North Range 5 West.

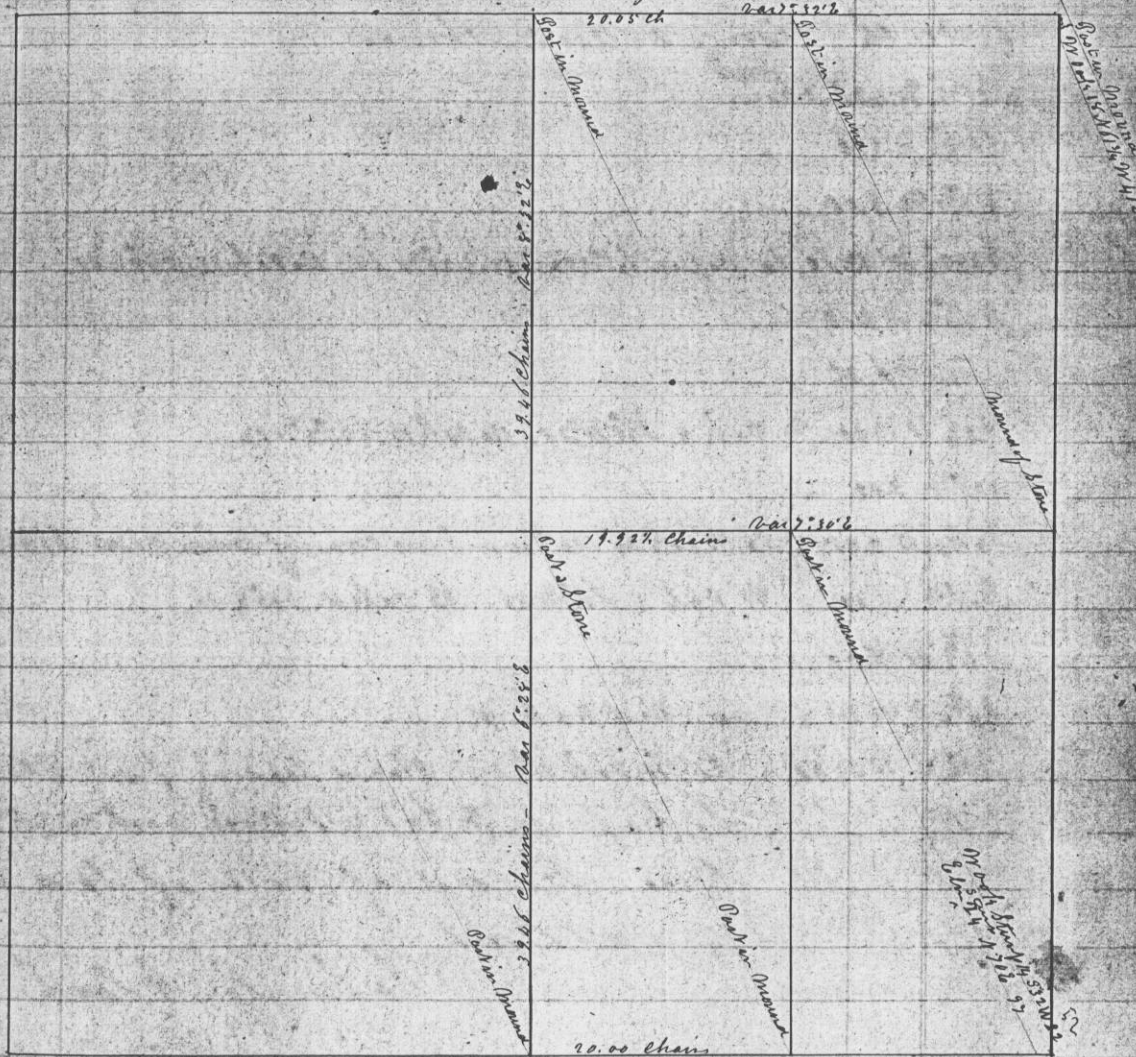

A true copy of the original notes &
 diagram of said survey
 Recorded October 20 1854. Attest

John G. Clark
 County Surveyor