


15B

No. 151

Survey made for Scott Barnett by A. A. McKain
of the N.E. 1/4 of S.W. 1/4 of Section 11
Town 7 Range 3 made Apr. 9 1857

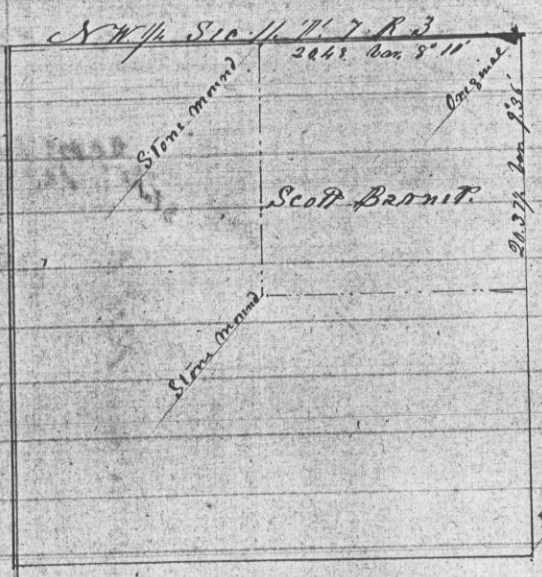


A true copy of the field
Notes of said Survey
Attest
C. Whitney Hayden
Co. Surveyor
Recorded June 16 1857

155A

No. 152

Survey for Joseph Kim by A. A. McKain
Dept. Co. Surveyor, of the N.W. 1/4 of S.W. 1/4 of
Section 11, Town 7 Range 3 made Apr. 8 & 9 1857

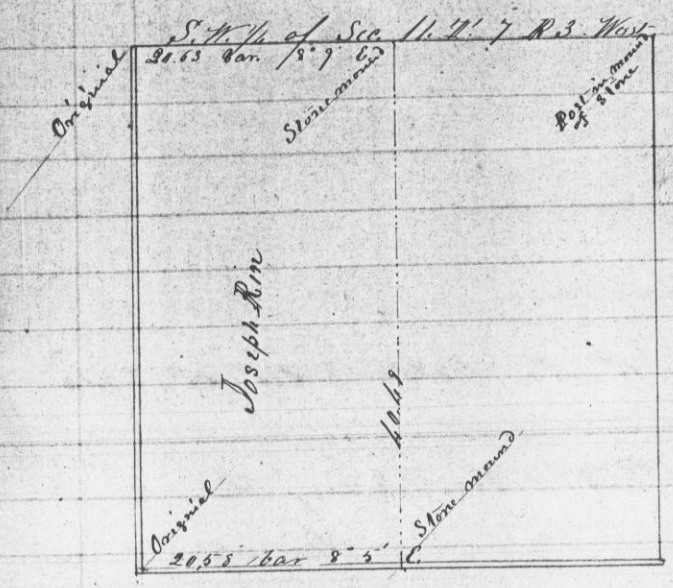


A true copy of the field notes of
said survey, Attest
C. Whitney Hayden
Co. Surveyor
RECORDED JUNE 15 1857

No. 153

15C

Survey made by A. A. McKain
Dept. Co. Surveyor, of the N.E. 1/4 of Section
11, Town 7 Range 3 for Geo. Stiffley
& Apr. 8 & 9 1857 Also of the N.E. 1/4 of S.E. 1/4
for Wm. Mead
Sec. 11, Town 7, Range 3 West

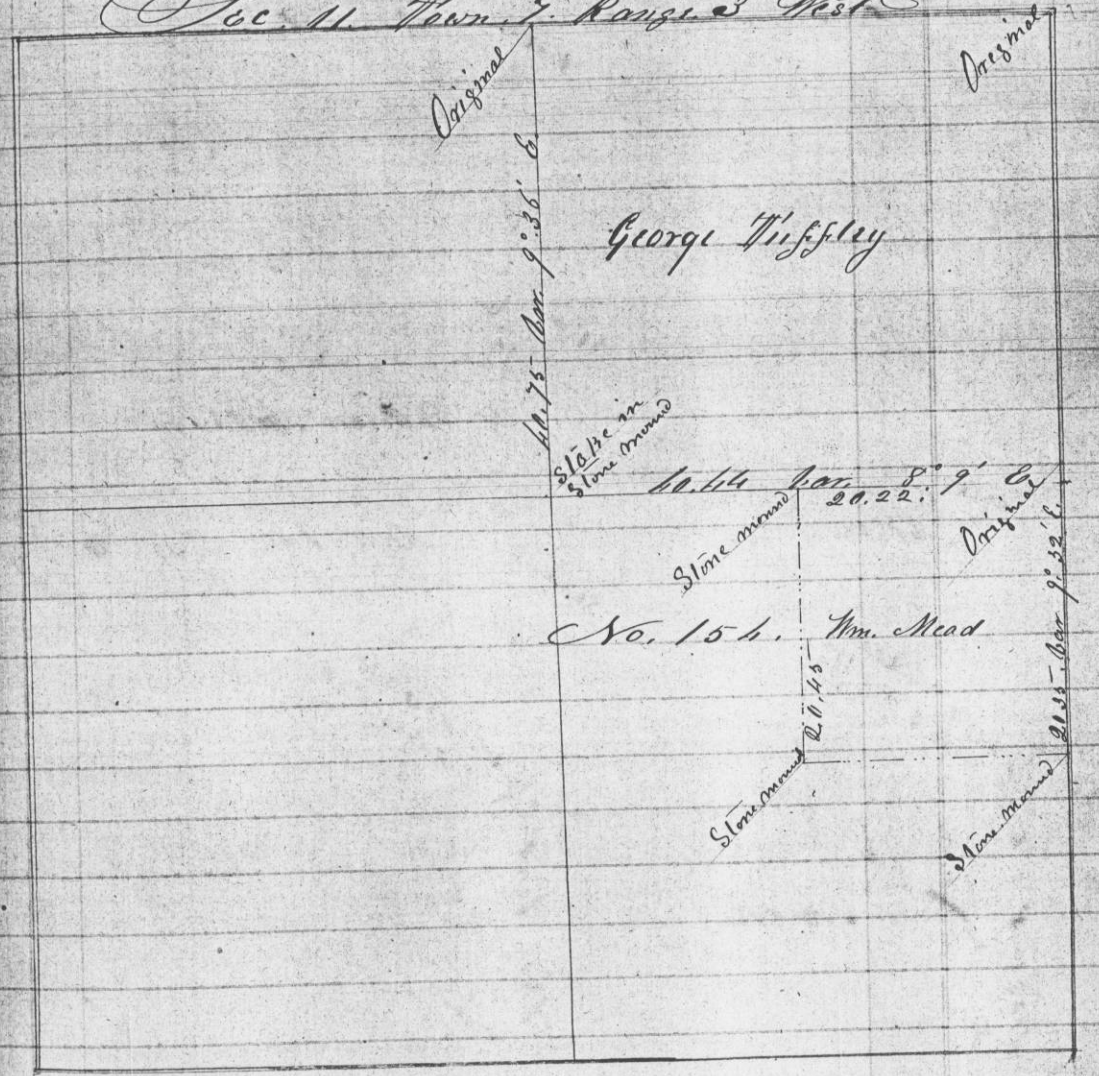

A true copy of the field notes
of said Survey
Attest, C. Whitney Hayden
Co. Surveyor
RECORDED JUNE 16 1857