


No. 163  
 Survey made June 2<sup>nd</sup> 1857 by  
 James Wilson Jr. Deput<sup>y</sup> Co. Surveyor of  
 N. 1/2 of N. 6. 1/4 & E. 1/2 of N. W. 1/4 for John Cooley  
 & E. 1/2 of N. 6. 1/4 & E. 1/2 of S. 6. 1/4 all of Section 5  
 Town 4 Range 5 for Geo. W. Fennell

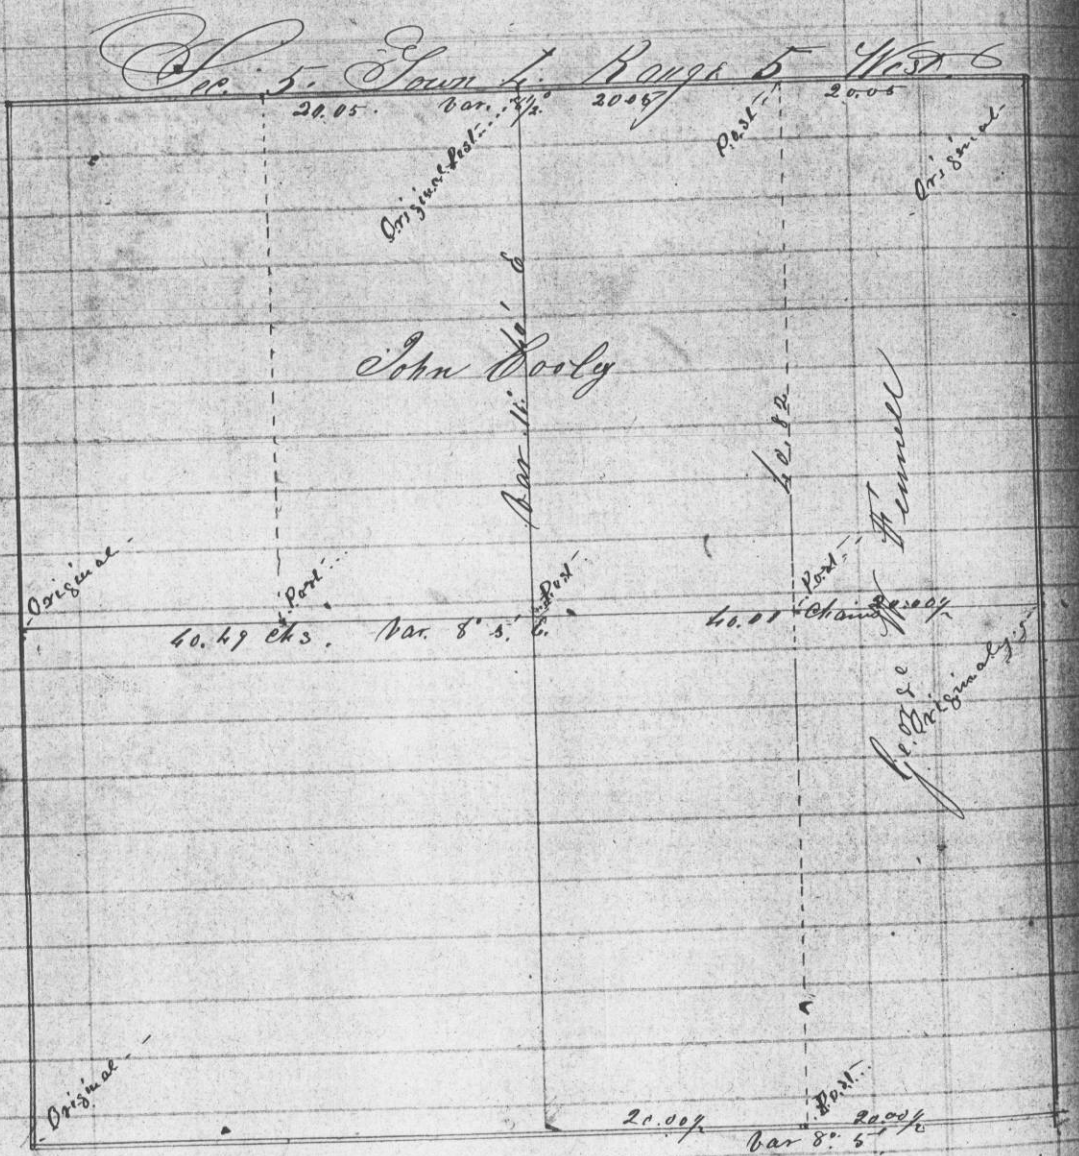


A true copy of the field notes  
 of said Survey  
 Attest

C. Whitney Hayden  
 Co. Surveyor

Recorded July 27 1857

Survey made June 3<sup>rd</sup> 1857 in Section  
 8 Town 4 Range 5 (N. 1/2) the E. 1/4 for H.  
 Wildman & E. 1/4 for H. Wildman also  
 in Section 17 same Town (N. 1/2) the E. 1/4 of  
 N. W. 1/4 for A. D. Yedder, the S. 1/2 of N. W. 1/4 for Mrs.  
 Fitch, & N. 6. 1/4 for E. Brookens. By James  
 Wilson Jr. Deput<sup>y</sup> Co. Surveyor

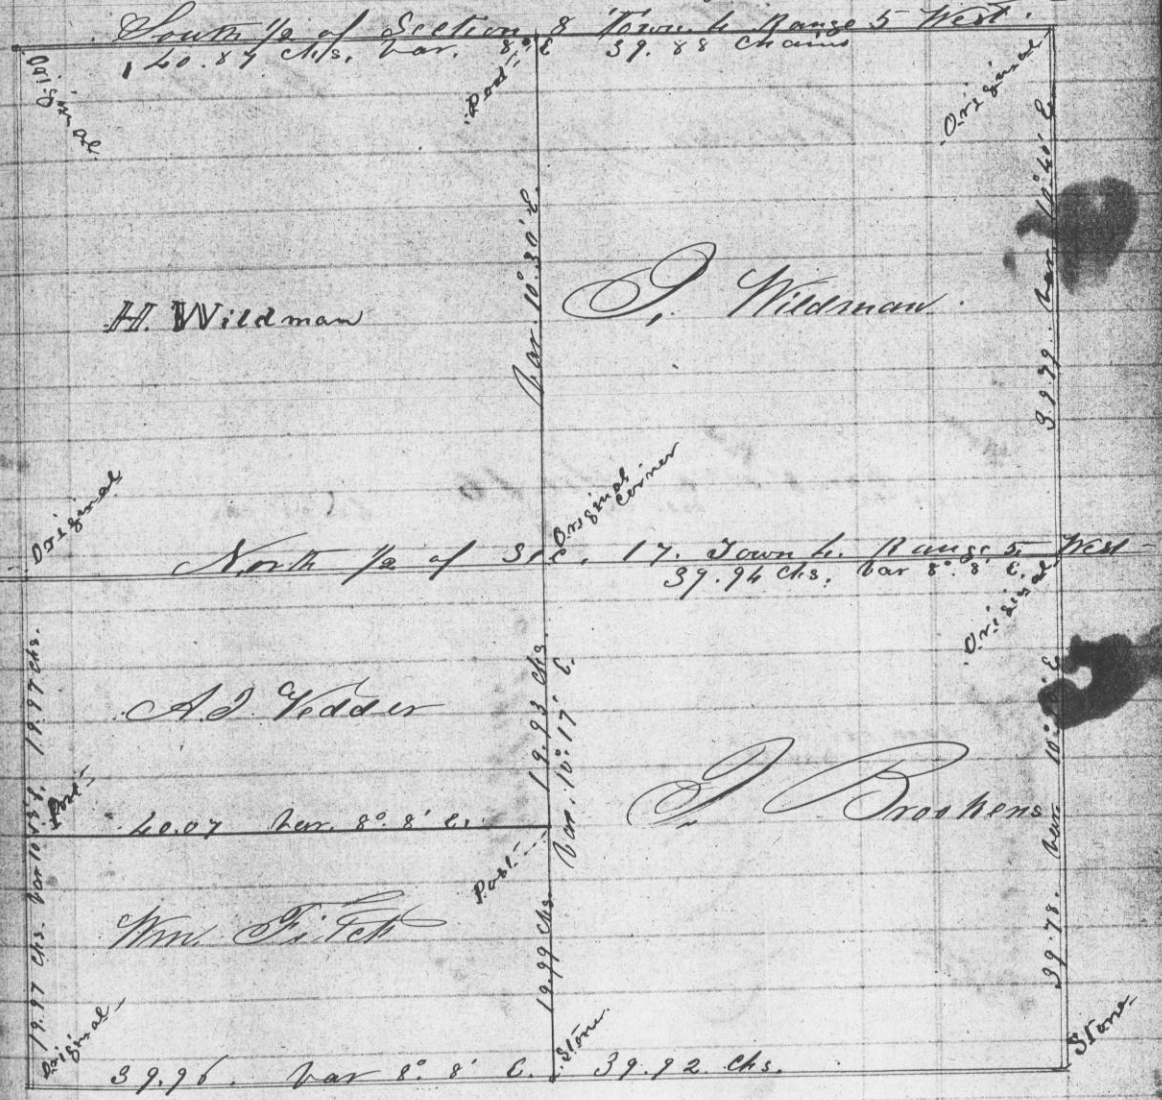

A true copy of the field notes of said  
 Survey  
 Attest

C. Whitney Hayden  
 Co. Surveyor

Recorded July 27 1857