


No 108

Survey made June 17 1857 by
James Wilson Jr. Deft. Co. Surveyor in
Section eleven Town Three Range five
West for Henry Burgess & O.B. & W.C.
McCartney

11-3-5

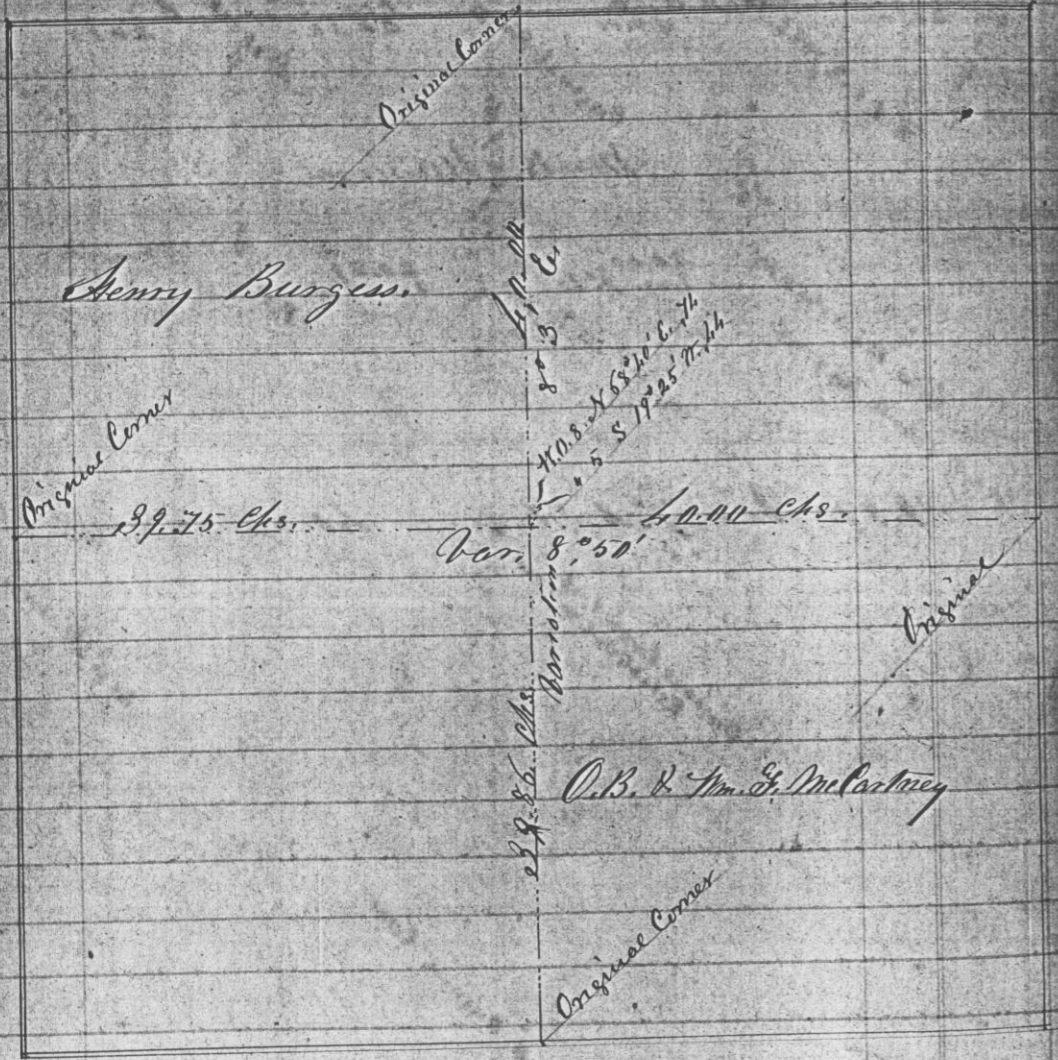


A true Copy
Attest C. Whitney Hayden
Co. Surveyor
Recorded Dec. 25 1857

No 109

Survey made June 30 1857 by James
Wilson Jr. Deft. Co. Surveyor in Section
Twenty nine Town Three Range two West

29-3-2

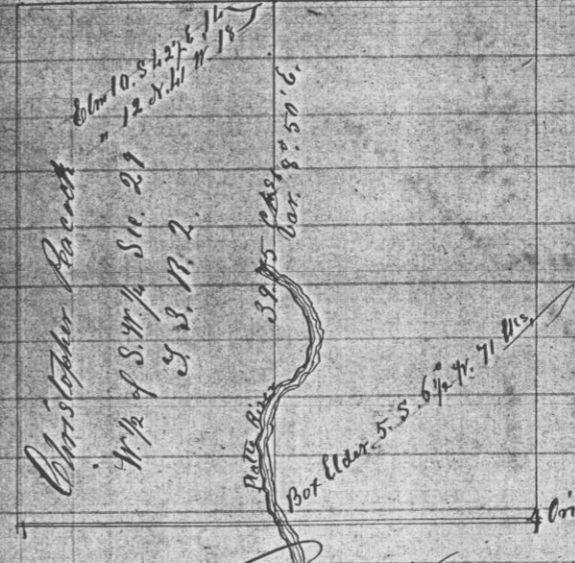

A true Copy
Attest C. Whitney Hayden
Co. Surveyor
Recorded Dec. 25 1857