


No. 178

Survey made Dec. 28, 1857 by Wm. N. Reed, Deft. Co. Surveyor for Thomas Bailie in Section Six Town Three Range Two, West.

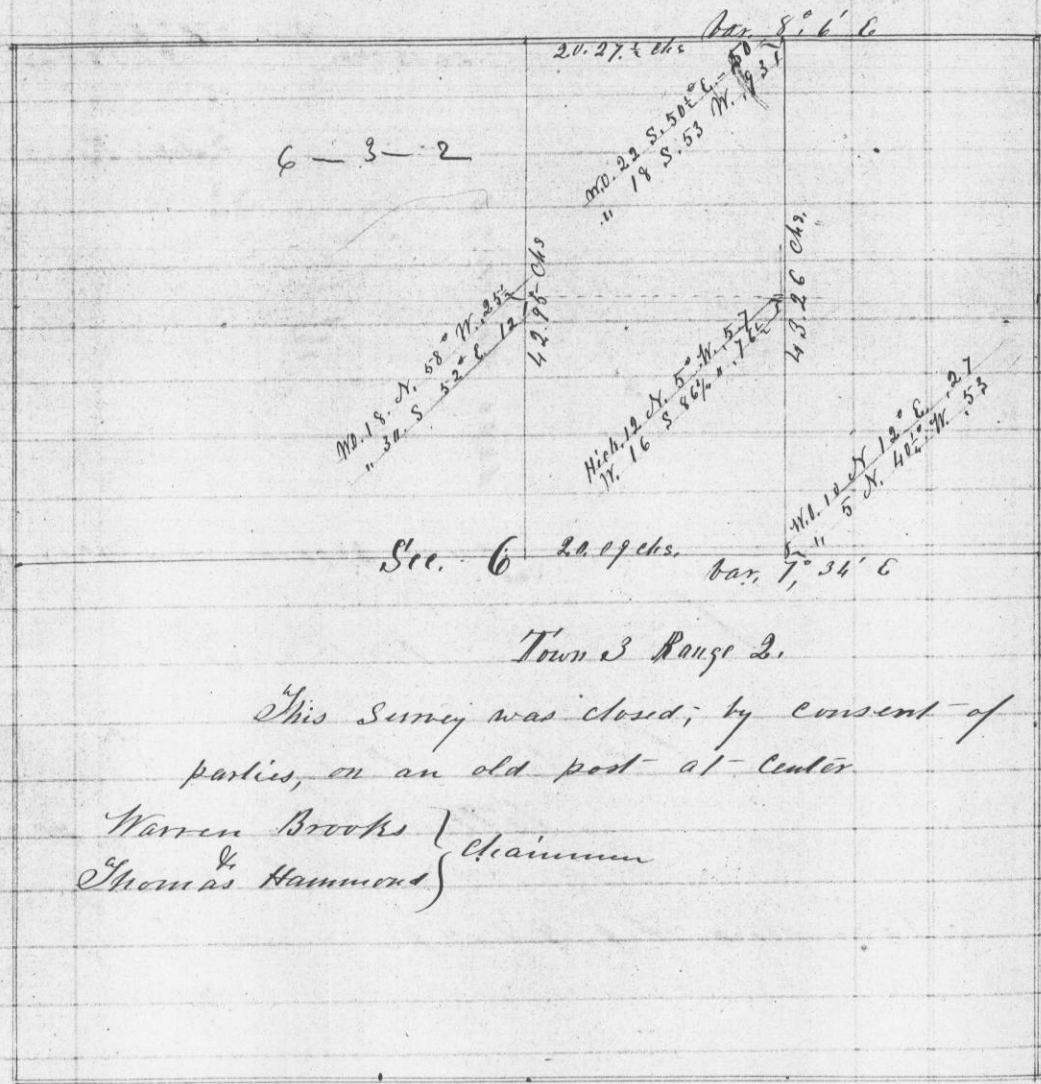

Warren Brooks }
Thomas Hammond } Chairman


A true copy of the field notes of said survey

Attest C. Whitney Hayden
Co. Surveyor

Recorded Feb. 11, 1858.

No. 179

Survey made by Wm. N. Reed Deft. Co. Surveyor in Section 16. Town 4. Range 2. West. Michael Swansick & John Tillet Chairman

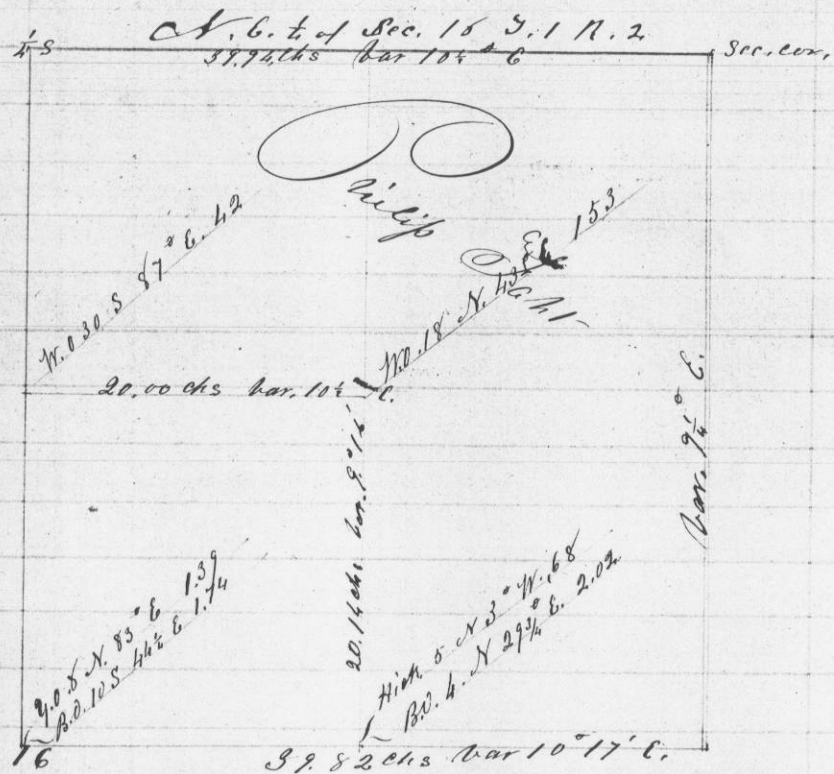

A true copy
Attest C. Whitney Hayden
Co. Surveyor

Recorded Feb. 11, 1858.