



Section 4 Town 3 Range 5

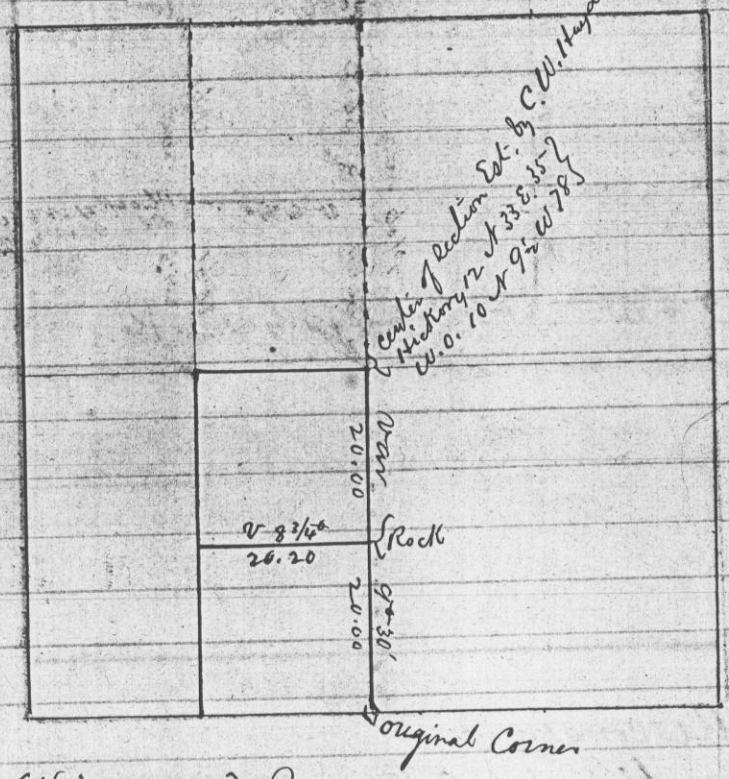

State of Wisconsin }
 County of Grant }
 I Joel Barber County
 Surveyor in and for the aforesaid County do
 hereby certify that I have surveyed the E/4
 of S W 1/4 of Section 4 Town 3 Range 5 as shown
 on the above map, and that the above map
 is a correct representation of said survey
 Given under my hand this 23rd day of Nov
 1867.

Joel Barber
 County Surveyor
 per James Wilson Jr.
 Dep Sec

Section No 27 Town 4 Range 5

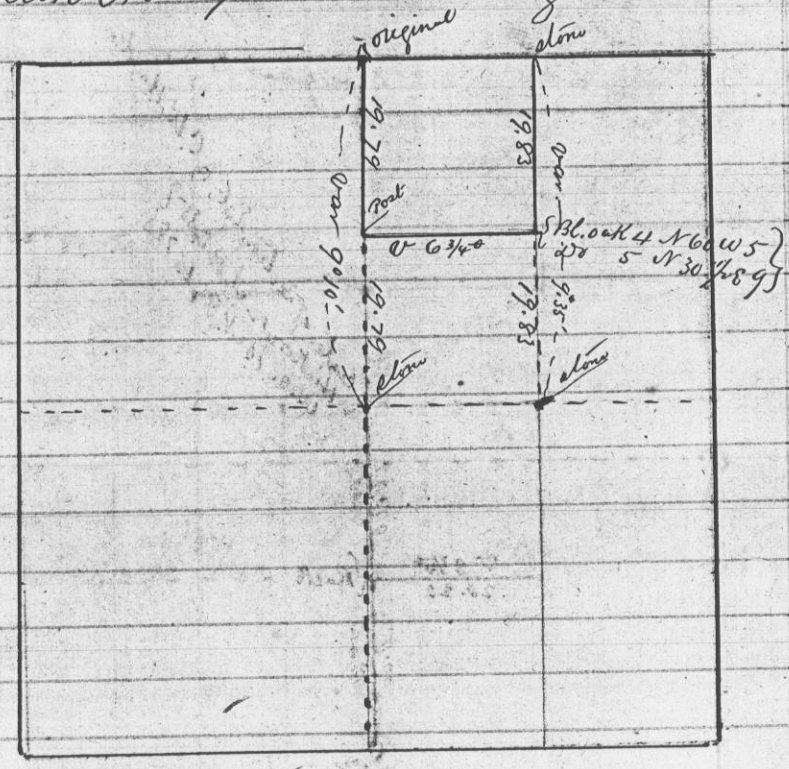

State of Wisconsin }
 County of Grant }
 I Joel Barber County
 Surveyor in and for the aforesaid County do
 hereby certify that I have surveyed and established
 the line between the N W 1/4 of the N E 1/4 and
 the S W 1/4 of the N E 1/4 of section No 27 Town
 4 Range 5 as shown on the above map
 The stones marked on the map were established
 by C.W. Hayden or Wm. N. Reed and I further
 certify that the above map is a correct repre-
 sentation of said survey
 Given under my hand this 22nd day of October 1867

Joel Barber
 County Surveyor
 per James Wilson Jr.
 Dep Sec