


(No 228)

Survey in A 2/4 of Section No 6 Town 5 R. 1
made April 6th 1870

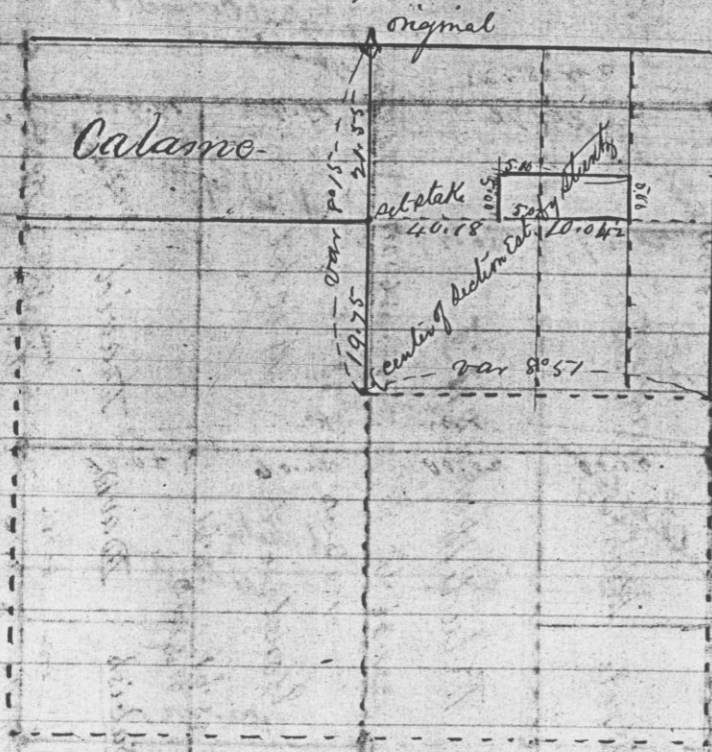

State of Wisconsin
County of Grant

I hereby certify that
the foregoing map is a correct representation
of said survey

Joseph Allen
County Surveyor

(No 229)

Survey of section 1 Town 6 Range 1 West



State of Wisconsin
County of Grant

I, Joseph Allen County
Surveyor in and for the aforesaid County do
hereby certify that I have surveyed and
subdivided section one in Town 6 Range 1 west
as shown in the above map, and that the
above map is a correct representation of
said survey

Given under my hand this 15th
day of May 1870

Joseph Allen
County Surveyor