


Section 14 Township 5 North Range 1 West of 4th P. M.

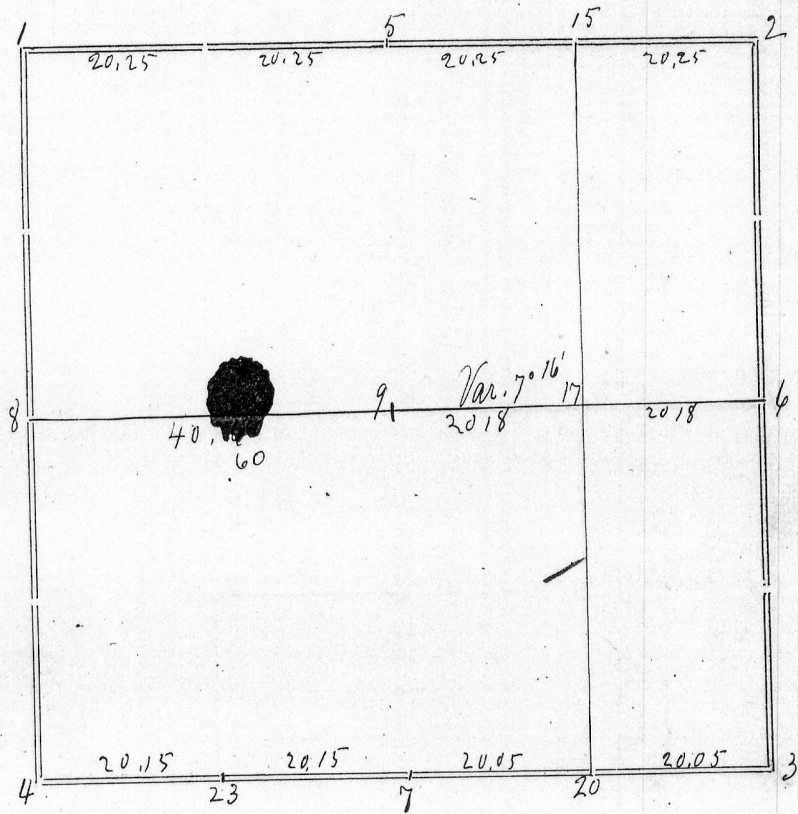

Corners	Bearing Trees	In. Dia.	Courses they Bear	Links Distant	REMARKS
1					Set stone at true identified Govt. corner
2					Ancient corner stone
3					Corner Stone set by Joseph Allen Co. Surv.
4					Established Corner by measuring from nearest Govt corners in four directions
5					Set large rock equidistant on true line
6					True corner found by Original bearings
7					Rock set by Joseph Allen
9	Br Oak Br Oak	7 8	S 36 E S 64 1/2 W	313 5.87	These are new bearings to the corner identified as the one set by Geo. R. Stantz Co. Surv.
15	Sandstone	15 x 10 x 8			by measurement of whole line.
17	Hickory Lynon	6 8	S 31 1/2 W S 57 3/4 E	139 98	
23	Stone	16 x 12 x 6			equidistant from 4 to 7

CERTIFICATE OF SURVEY.

STATE OF WISCONSIN, } ss.
GRANT COUNTY,

I, Joel Barber, County Surveyor in and for the County

and State aforesaid, do hereby certify that I have executed the Survey represented by the foregoing Plat and annexed Field Notes of Survey, in accordance with the State Laws and Instructions of the Commissioner of the General Land Office. Scale, 80 chains to 4 inches. The figures in red ink are the lengths of the lines as stated in the Field Notes of the Government Survey.

Declination of the Magnetic Meridian from the True Meridian East. The variation of needle adopted in establishing corners is 8° 30' East.

WITNESS my hand this 2nd day of March A. D. 1877.

William Fisher
Knud Haquerseth } CHAINMEN.

Joel Barber Co. SURVEYOR.