


Section 20 Township 4 North Range 5 West of 4th P. M.

83  
80 1/2

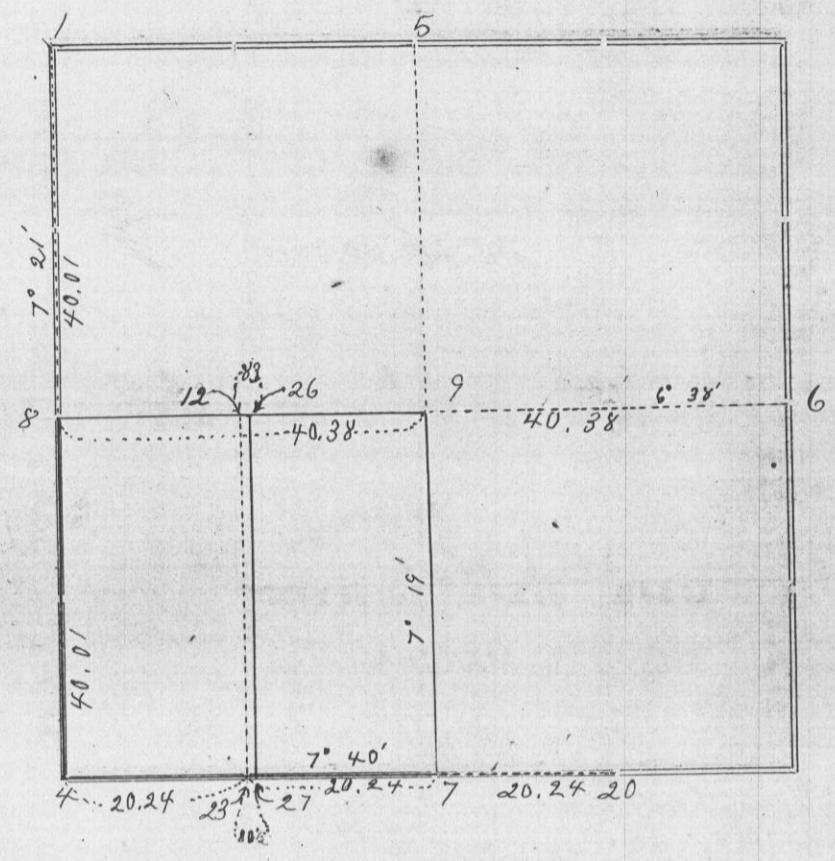

Corners	Bearing Trees	In. Dia.	Courses they Bear	Links Distant	REMARKS
1	Stake				set in place where original stake was found
5	Post				on original corner
6	Post				on original corner Found stump of White Oak witness tree; other tree entirely gone
7	Stake				Old stake entirely gone, Relocated proportionally between (4) and (20)
8	Stake				Old stake gone; Relocated midway between (1) and (4)
9	Stake				driven at intersection of quarter lines
12	Stake				Set midway between (8) and (9)
20	Stone				located by some previous surveyor
23	Stake				Mid way between (4) and (7)
26	Stone				located 83 links East of (12)
27	Stake				located 80 1/2 links East of (23)
4	Original corner				

CERTIFICATE OF SURVEY.

STATE OF WISCONSIN, } ss.  
 GRANT COUNTY, }  
 I, F. C. Beardley Deputy, County Surveyor in and for the County and State aforesaid, do hereby certify that I have executed the Survey represented by the foregoing Plat and annexed Field Notes of Survey, in accordance with the State Laws and Instructions of the Commissioner of the General Land Office. Scale, 80 chains to 4 inches. The figures in red ink are the lengths of the lines as stated in the Field Notes of the Government Survey.

Declination of the Magnetic Meridian from the True Meridian ..... East. The variation of needle adopted in establishing corners is 7° 30' East.

WITNESS my hand this 5<sup>th</sup> day of December A. D. 1884

..... } CHAINMEN.  
F. C. Beardley SURVEYOR.