


Section 34 Township 7 North Range 5 West of 4th P. M.

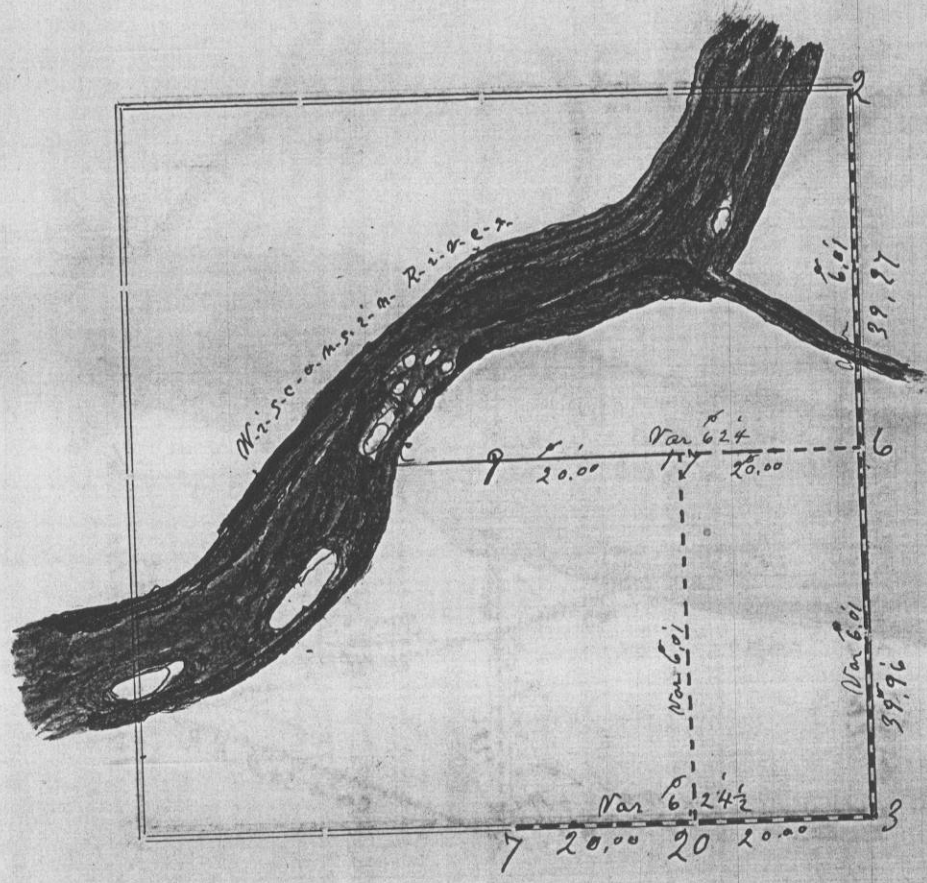

Corners	Bearing Trees	In. Dia.	Courses they Bear	Links Distant	REMARKS
2	oak Secretary	12 6	N 5 1/2 E N 63 E	166 141	
6	oak "	8 24	S 8 1/2 W N 43 "	62 104	Established from the remains of original bearings
7	Buried block of oak				
9	oak or oak	8 4	N 15 3/4 E S 72 1/2 W	109 51	
17	parties		promised to set	stone	
8	"		"	"	

CERTIFICATE OF SURVEY.

STATE OF WISCONSIN, }
 GRANT COUNTY, } ss. I, H. J. Gould, County Surveyor in and for the County
 and State aforesaid, do hereby certify that I have executed the Survey represented by the foregoing Plat and annexed Field Notes of Survey, in
 accordance with the State Laws and Instructions of the Commissioner of the General Land Office. Scale, 80 chains to 4 inches. The figures
 in red ink are the lengths of the lines as stated in the Field Notes of the Government Survey.
 Declination of the Magnetic Meridian from the True Meridian..... East. The variation of needle adopted
 in establishing corners is..... East.
 WITNESS my hand this 24 day of Sept A. D. 1888
A. Foster } CHAINMEN
Will Foster }
H. J. Gould } SURVEYOR
Deputy }