


Section 9 Township 5 North Range 1 West of 4th P. M.

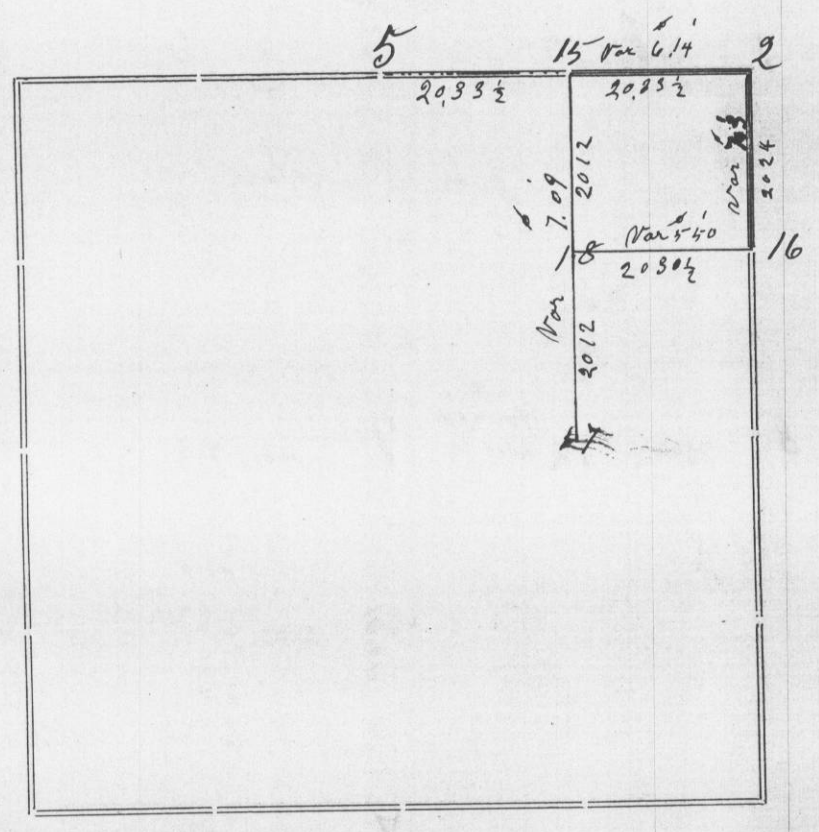

Corners	Bearing Trees	In. Dia.	Courses they Bear	Links Distant	REMARKS
2	Original				Stone set by same surveyor in 1848. found to be correct.
5	elm	12	S 35 1/2 E	77 1/2	Established from the remains of the old stumps.
	" "	10	N 7 W	90	
15	Set Stone	4X7X32 in			Established in 1848
18	Set Stone	6X7X8			" "
16	Set Stone	5X6X12			" "
17	Os Oak	9	N 84 W	27	" "
	" "	8	N 44 E	50	
	" "	10	N 66 3/4 E	56 1/2	

CERTIFICATE OF SURVEY.

STATE OF WISCONSIN, } ss.
GRANT COUNTY,

I, Herbert J. Gould, County Surveyor in and for the County

and State aforesaid, do hereby certify that I have executed the Survey represented by the foregoing Plat and annexed Field Notes of Survey, in accordance with the State Laws and Instructions of the Commissioner of the General Land Office. Scale, 80 chains to 4 inches. The figures in red ink are the lengths of the lines as stated in the Field Notes of the Government Survey.

Declination of the Magnetic Meridian from the True Meridian East. The variation of needle adopted in establishing corners is 6.3° East.

WITNESS my hand this 18 day of April A. D. 1889.

Wm. C. Sals
C. S. E. Washburn. } CHAINMEN.

Herbert J. Gould SURVEYOR.