


Section 5 Township 7 North Range 2 West of 4th P. M.

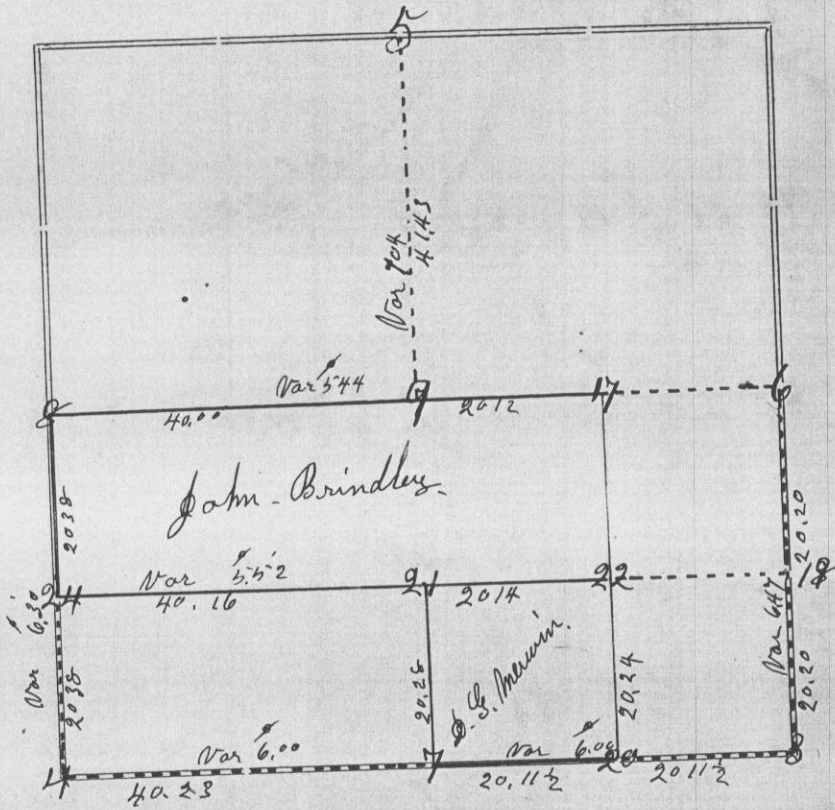

Corners	Bearing Trees	In. Dia.	Courses they Bear	Links Distant	REMARKS
3	Elm	18	N 34 1/2 E	75	one stump still in good condition
4	Original				one both trees in good condition
6	Stake in pile of stone				
7	Br O	16	S 3 W	84	all trace of witness tree gone so I run a straight line from 3 to 4 placing 1/4 corner at equal distance from each as per original plat.
8	Original				Both trees in good condition
9	Set Stone	8x8x16 in			
17					
20	Br Oak	4	S 82 1/2 E	24	
21	B Oak Br "	18 8	N 74 W South	47 105	
22	B Oak " "	8 8	N 88 1/2 E N 5 "	9 222	
24	Stake in pile of stone				

CERTIFICATE OF SURVEY.

STATE OF WISCONSIN, } ss. Herbert J. Gold County Surveyor in and for the County
 GRANT COUNTY, }
 and State aforesaid, do hereby certify that I have executed the Survey represented by the foregoing Plat and annexed Field Notes of Survey, in accordance with the State Laws and Instructions of the Commissioner of the General Land Office. Scale, 80 chains to 4 inches. The figures in red ink are the lengths of the lines as stated in the Field Notes of the Government Survey.
 Declination of the Magnetic Meridian from the True Meridian East. The variation of needle adopted in establishing corners is East.
 WITNESS my hand this 9 day of Sept A. D. 1889.
Chas. Young } CHAINMEN.
Willie Merwin } Herbert J. Gold SURVEYOR.