


Section 2 Township 6 North Range 5 West of 4th R., 1st.

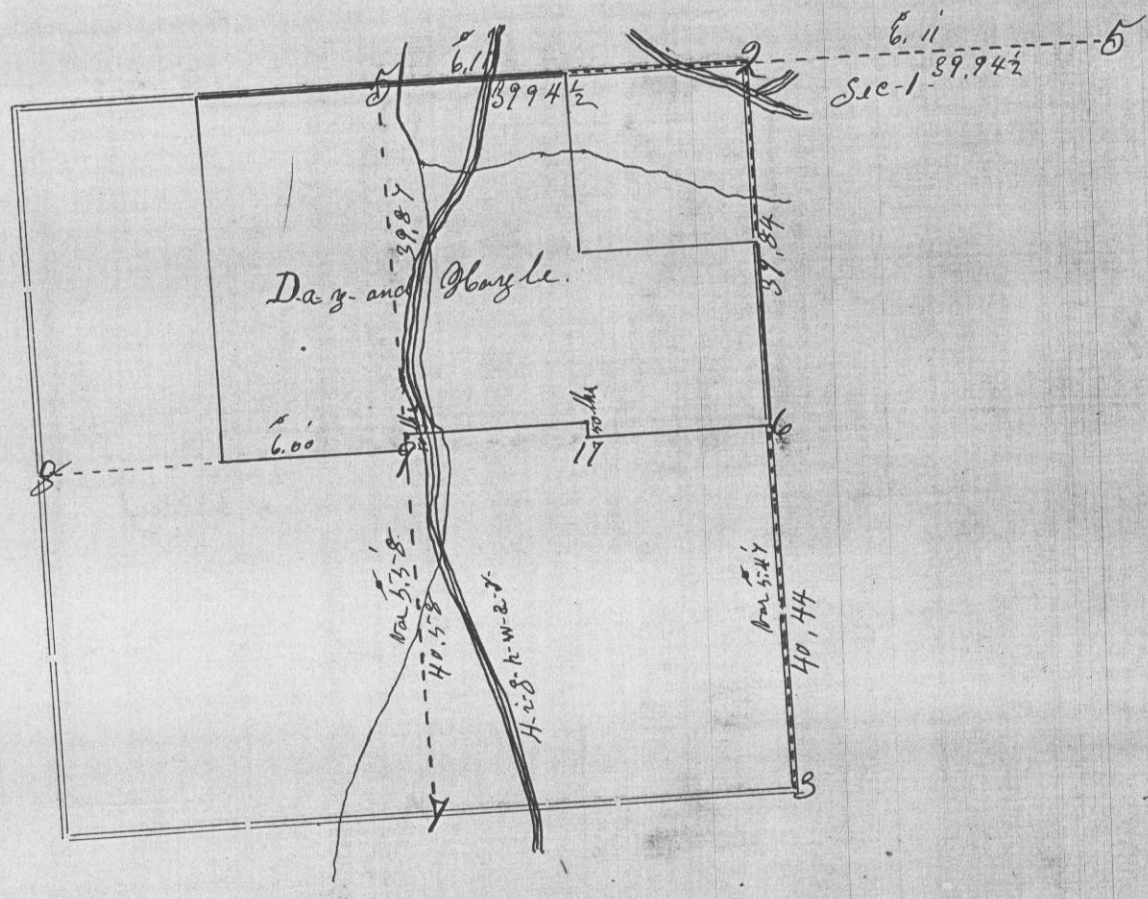

Corners	Bearing Trees	In. Dia.	Courses they Bear	Links Distant	REMARKS
5	Br Oak	6	N 69° W	26	This is the bearings for corner in Town of The Cornu is 16 lbs west.
	" "	8	" 21 E	15	
2	Set Stake				Established by running a straight line from no 5-3-1 to no 5-3-2
6	Set Stone	4x9x13 in			Established from the remains of the stumps of both witness trees
8	W Oak	24	N 3 1/2 E	57	
9	Br Oak	8	S 11 W	16 1/2	
		6	N 22 1/4 E	24	
17	W Oak	5	N 16 1/2 W	51	
		18	S 67 E	75	

CERTIFICATE OF SURVEY.

STATE OF WISCONSIN, } ss.  
 GRANT COUNTY, }  
 I, \_\_\_\_\_, County Surveyor in and for the County  
 and State aforesaid, do hereby certify that I have executed the Survey represented by the foregoing Plat and annexed Field Notes of Survey, in  
 accordance with the State Laws and Instructions of the Commissioner of the General Land Office. Scale, 80 chains to 4 inches. The figures  
 in red ink are the lengths of the lines as stated in the Field Notes of the Government Survey.  
 Declination of the Magnetic Meridian from the True Meridian... East. The variation of needle adopted  
 in establishing corners is... East.  
 WITNESS my hand this... 25... day of... Oct... A. D. 1889.  
 \_\_\_\_\_ } CHAINMEN.  
 \_\_\_\_\_ }  
 \_\_\_\_\_ SURVEYOR.