


Section 22 Township 7 North Range 4 West of 4th P. M.

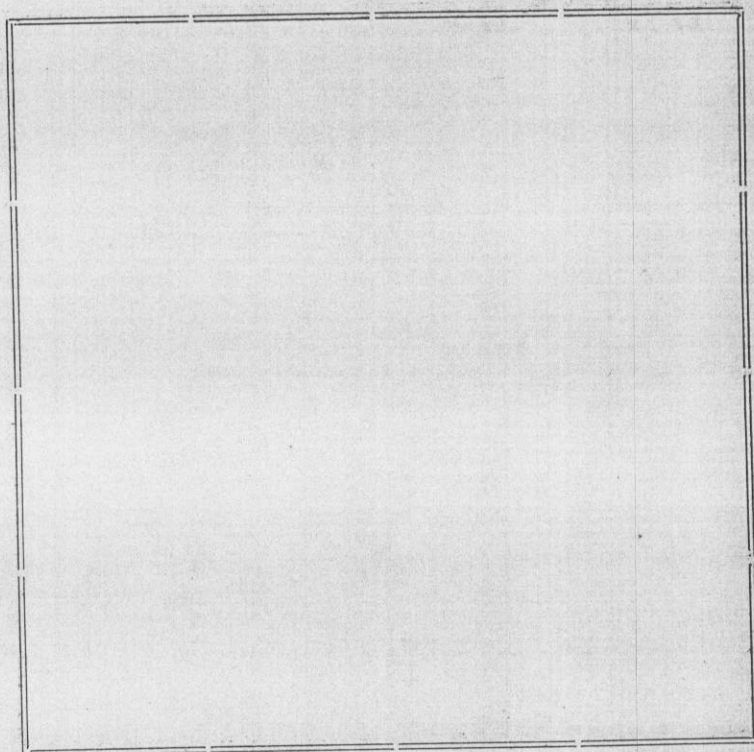

Corners	Bearing Trees	In. Dia.	Courses they Bear	Links Distant	REMARKS
					Beginning at a point in the S E 1/4 of S W 1/4 of
					Sec 22 - T-7 - R-4 - on the top of ledge of
					rocks
					Bearings Br Oak 10 S & E 194 thence
					S 50 1/2 E 5 3/4 rods to
					W Oak 12 N 25 W 190
					" " 10 " 53 E 142
					South one acre more or less taking one rod
					and two rods north of said described line

CERTIFICATE OF SURVEY.

STATE OF WISCONSIN, } ss.
GRANT COUNTY,

I, Herbert J. Gould, County Surveyor in and for the County

and State aforesaid, do hereby certify that I have executed the Survey represented by the foregoing Plat and annexed Field Notes of Survey, in accordance with the State Laws and Instructions of the Commissioner of the General Land Office. Scale, 80 chains to 4 inches. The figures in red ink are the lengths of the lines as stated in the Field Notes of the Government Survey.

Declination of the Magnetic Meridian from the True Meridian East. The variation of needle adopted in establishing corners is 6 1/2 East.

WITNESS my hand this 29 day of May A. D. 1891.

Henry Bennis
Ernest Koss } CHAINMEN.

Herbert J. Gould SURVEYOR.