


Section 31 Township 7 North Range 4 West of 4th P. M.

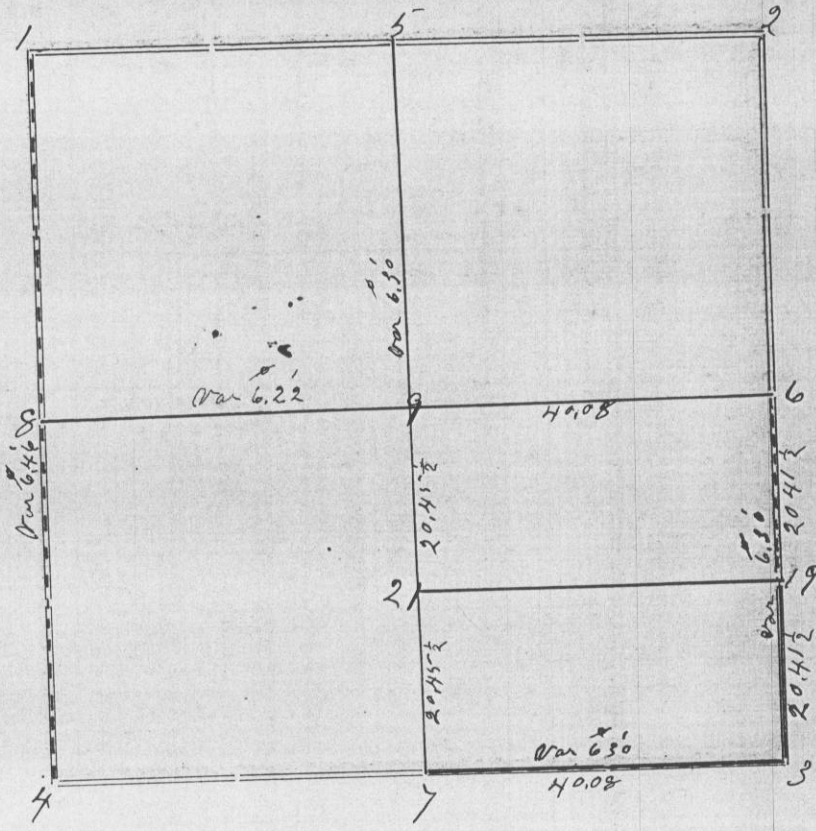

Surveyed for J. B. Russell.

Corners	Bearing Trees	In. Dia.	Courses they Bear	Links Distant	REMARKS
1					cedar stake set by same previous surveyor
3	set stone		3 X 7 X 12 in		one tree in good condition
4					" " " "
5	B Oak	24	N 63 1/2 E	85	Established from the remains of stumps of original bearing
6	set stone		4 X 10 X 24 in		" " " "
7					Both trees in good condition
9	W Oak Hickory	12 8	S 13 E N 86 E	207 354	
19	set stone		2 1/2 X 12 X	14 in	
21	Hickory Br Oak	8 12	S 86 E N 44 1/2 W	95 164	

CERTIFICATE OF SURVEY.

STATE OF WISCONSIN, } ss.
GRANT COUNTY,

I, H. J. Gould, County Surveyor in and for the County

and State aforesaid, do hereby certify that I have executed the Survey represented by the foregoing Plat and annexed Field Notes of Survey, in accordance with the State Laws and Instructions of the Commissioner of the General Land Office. Scale, 80 chains to 4 inches. The figures in red ink are the lengths of the lines as stated in the Field Notes of the Government Survey.

Declination of the Magnetic Meridian from the True Meridian East. The variation of needle adopted in establishing corners is 6.30 East.

WITNESS my hand this 12 day of December A. D. 1890

Otis Russell
Albert Colburn } CHAINMEN.

H. J. Gould SURVEYOR.