


Section 33 Township 3 North Range 9 West of 4th P. M.

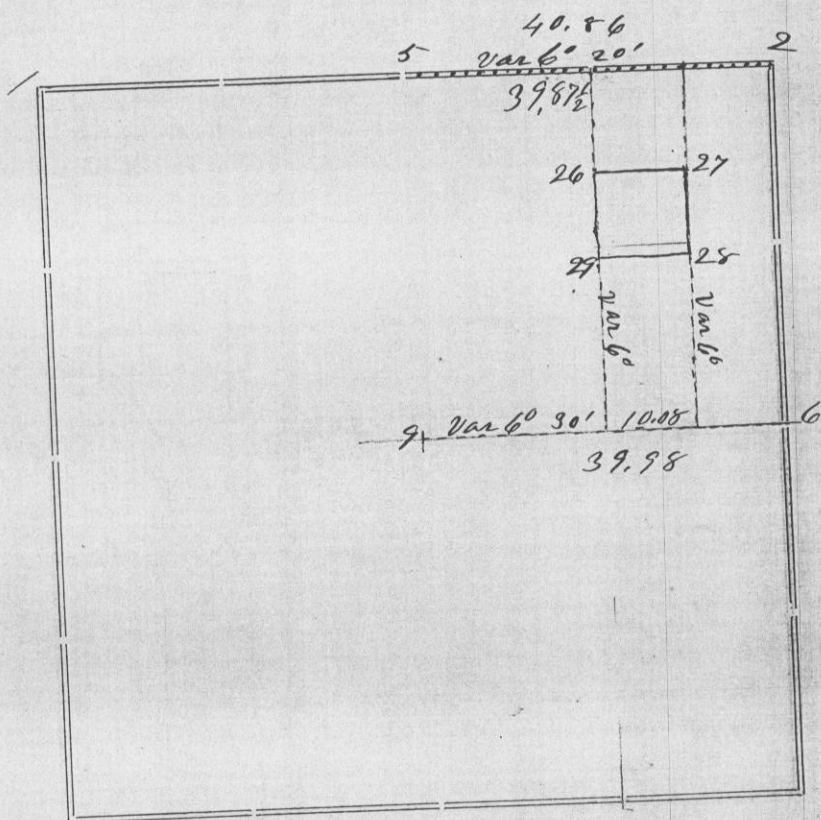

Corners	Bearing Trees	In. Dia.	Courses they Bear	Links Distant	REMARKS
2	Original corner remains		Stump of one tree		
5	Stone set by Dr. Fall		both trees gone		
9	Established by Sturdy in 1855		found rolling trees		
6	both trees gone				
26	Willow at Cor. of margin	8	N 6° 6' E	108 1/2	
28	White Oak	10	S 72 1/2° W	49	
	" " "	9	N 55° W	46	
29	Blk Walnut	7	N 22 1/2° E	43	
	" " "	6	S 41 1/2° W	46	

CERTIFICATE OF SURVEY.

STATE OF WISCONSIN, } ss.
GRANT COUNTY,

I, Charles Sampson Deputy, County Surveyor in and for the County

and State aforesaid, do hereby certify that I have executed the Survey represented by the foregoing Plat and annexed Field Notes of Survey, in accordance with the State Laws and Instructions of the Commissioner of the General Land Office. Scale, 80 chains to 4 inches. The figures in red ink are the lengths of the lines as stated in the Field Notes of the Government Survey.

Declination of the Magnetic Meridian from the True Meridian 4 1/2° East. The variation of needle adopted in establishing corners is 4 1/2° East.

WITNESS my hand this 27th day of April A. D. 1891.

Bernard Elze
R. R. Swale } CHAINMEN.

Charles Sampson SURVEYOR.