


Section 8 Township 5 North Range 6 West of 4th P.M.

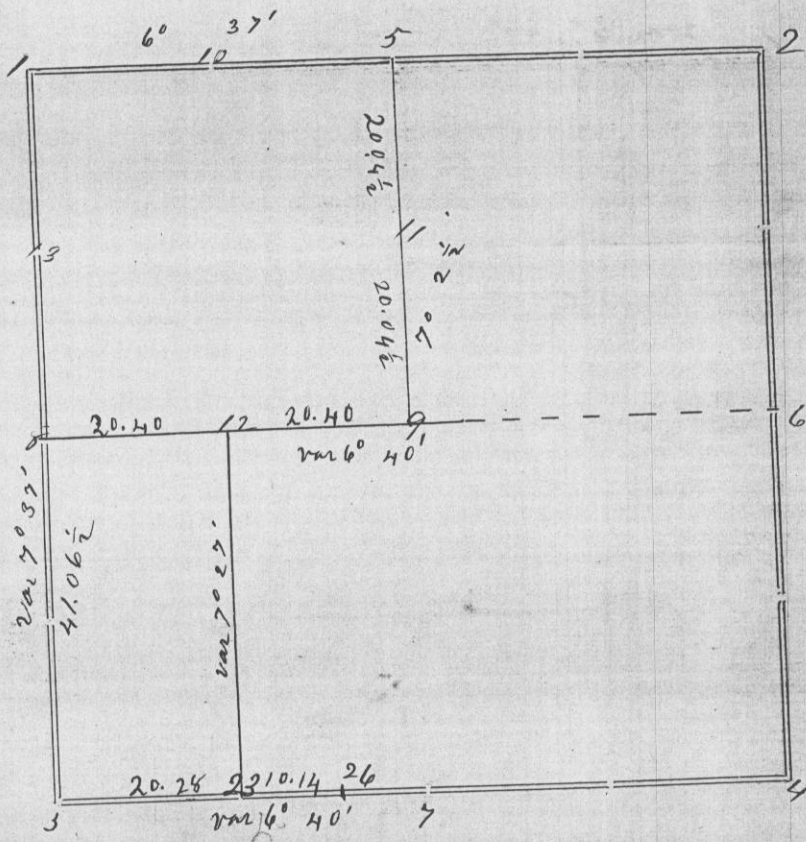

Corners	Bearing Trees	In. Dia.	Courses they Bear	Links Distant	REMARKS
1	Stone				Found W.O. instead of W. Ash at proper course and distance from cor. Found remains of P.O.
7	Stake				Found W.F. in good condition
8	Found Stone				set by previous surveyor but have doubts of its correctness
3	Blk Oak	12	S 3 1/2 E	176	new Established by running to four adjacent corners
9					Established by Barker found both of his W.F.'s
11					" " " " " " " "
5					Found remains of both original W.F.'s
10	Stake				
12	W Oak	36	S 22 E	22 1/2	
23	Blk Oak yellow	15 15	N 38 1/2 E S 73 1/2 W	58 1/2 97 1/4	
26	Pine oak white oak	15 8	N 1 W N 62 W	84 1/2 23	

CERTIFICATE OF SURVEY.

STATE OF WISCONSIN, } ss.
GRANT COUNTY, }

I, Charles Sampson, County Surveyor in and for the County and State aforesaid, do hereby certify that I have executed the Survey represented by the foregoing Plat and annexed Field Notes of Survey, in accordance with the State Laws and Instructions of the Commissioner of the General Land Office. Scale, 80 chains to 4 inches. The figures in red ink are the lengths of the lines as stated in the Field Notes of the Government Survey.

Declination of the Magnetic Meridian from the True Meridian 6° 20' East. The variation of needle adopted in establishing corners is East.

WITNESS my hand this 6th day of July A. D. 1891.

John Mung
John Reedy } CHAINMEN.

Charles Sampson SURVEYOR.