


Section 5 Township 5 North Range 6 West of 4th P. M.

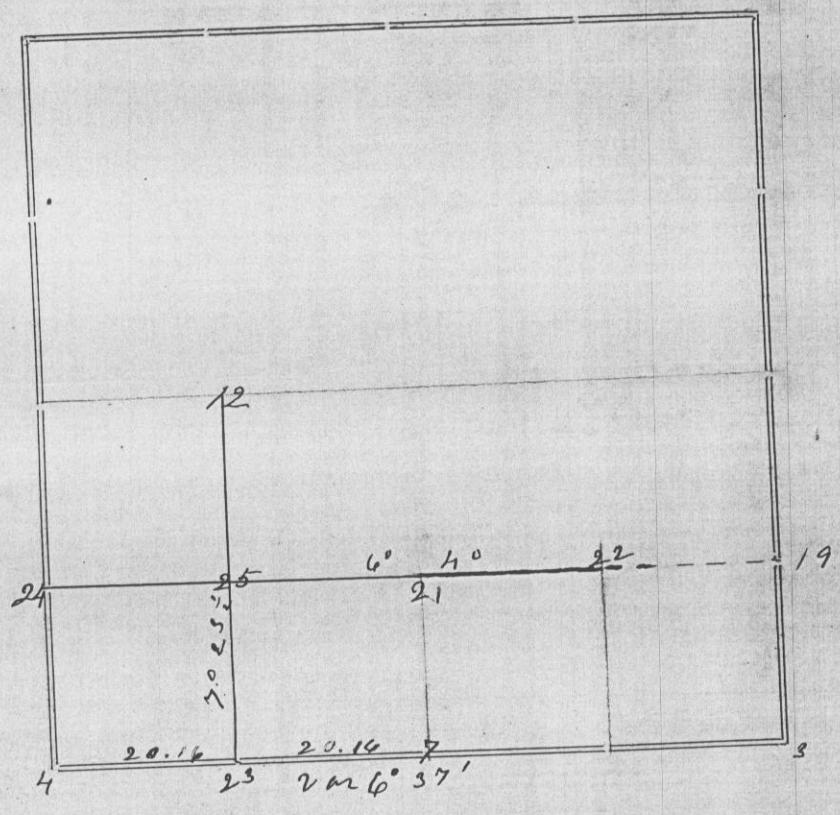

Corners	Bearing Trees	In. Dia.	Courses they Bear	Links Distant	REMARKS
7					same as 5 page 199
4					" " " " " "
23	stake				
12	stake set by J. C. Scott				
25	stake				
21	" "				
22	" "				
19	stake set by J. C. Scott				

CERTIFICATE OF SURVEY.

STATE OF WISCONSIN, } ss.
 GRANT COUNTY, }
 I, Charles Sampson, County Surveyor in and for the County
 and State aforesaid, do hereby certify that I have executed the Survey represented by the foregoing Plat and annexed Field Notes of Survey, in
 accordance with the State Laws and Instructions of the Commissioner of the General Land Office. Scale, 80 chains to 4 inches. The figures
 in red ink are the lengths of the lines as stated in the Field Notes of the Government Survey.
 Declination of the Magnetic Meridian from the True Meridian East. The variation of needle adopted
 in establishing corners is 6° 40' East.
 WITNESS my hand this 6th day of July A. D. 1871.
John Hung } CHAINMEN.
John Rady }
Charles Sampson SURVEYOR.