


Section 14 Township 4 North Range 1 West of 4th P.M.

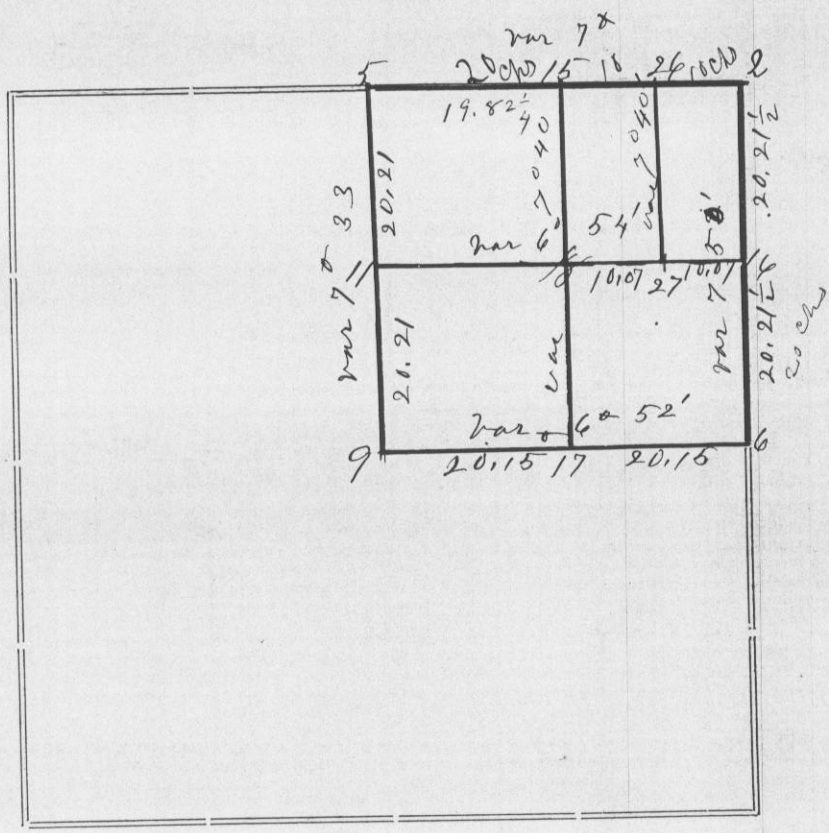

Corners	Bearing Trees	In. Dia.	Courses they Bear	Links Distant	REMARKS
2	Established from nearest adjacent corner same as 1 on previous page				
5	B.C. original B.T. still standing				
6	Same as 8 on previous page				
9	Established by Hurst				
15	Slake corner promised to put in stone				
16	Ancient stone				
11	Slake				
18	White oak	24	S 80° 20'	69 1/2	
	" " "	30	S 71 1/2° 20'	100 1/2	
24	Slake				
27	White oak	4	N 80 1/2° E	106 1/2	
	Pin " "	8	N 82° E	110 1/2	

CERTIFICATE OF SURVEY.

STATE OF WISCONSIN, } ss.
 GRANT COUNTY, }
 I, Charles Sampson, County Surveyor in and for the County and State aforesaid, do hereby certify that I have executed the Survey represented by the foregoing Plat and annexed Field Notes of Survey, in accordance with the State Laws and Instructions of the Commissioner of the General Land Office. Scale, 80 chains to 4 inches. The figures in red ink are the lengths of the lines as stated in the Field Notes of the Government Survey.

Declination of the Magnetic Meridian from the True Meridian 6 1/2 East. The variation of needle adopted in establishing corners is 7 1/2 East.

WITNESS my hand this 7th day of March A. D. 1892

Charles Peterson } CHAINMEN.
Orville Barrett }

Charles Sampson SURVEYOR.