


Section 21 Township 8 North Range 1 West of 4th P. M.

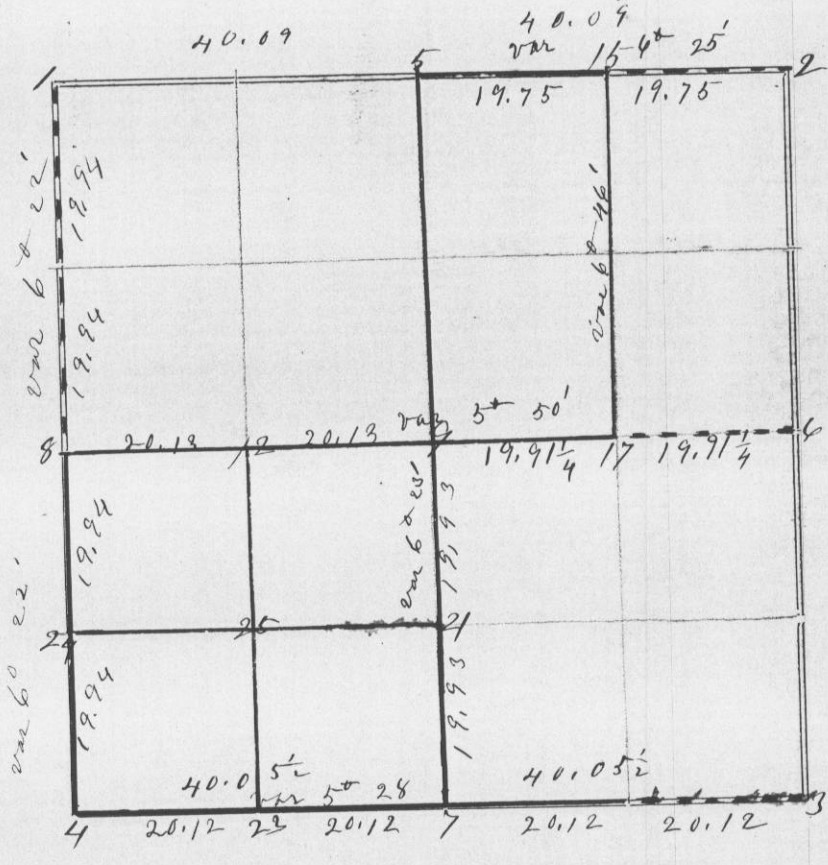

Corners	Bearing Trees	In. Dia.	Courses they Bear	Links Distant	REMARKS
1	Both original		Trees standing		
2	Rock put in		by Burton		
3	both original		in good condition		
4	Rock established		from four nearest adjacent corners		
5	white oak tree		still standing		
6	found stumps		of both original B.T.'s		
7	Established		from a survey of whole section about 600 ft east of old fence		
8	Established		from survey of whole section		
9	Black Oak	8	N 7 1/2 E	82	
	" " "	"	S 89 E	70	
8	Double Black Oak	10	S 40 E	3, 3 1/2	
	Black Oak	12	S 27 1/2 E	3, 57	
21	white oak	30	N 10 W	82 1/2	
	" "	30	N 41 W	75 1/2	
23	four oak	12	west	8	
24	Black Oak	8	N 31 1/2 E	83 1/2	
	Yallow	10	S. W.	14	
25	four oak	4	S 68 1/2 E	150	
	elm	4	S 45 1/2 E	139	

CERTIFICATE OF SURVEY.

STATE OF WISCONSIN, } ss.
 GRANT COUNTY, }
 I, Charles Sampson, Deputy, County Surveyor in and for the County and State aforesaid, do hereby certify that I have executed the Survey represented by the foregoing Plat and annexed Field Notes of Survey, in accordance with the State Laws and Instructions of the Commissioner of the General Land Office. Scale, 80 chains to 4 inches. The figures in red ink are the lengths of the lines as stated in the Field Notes of the Government Survey.

Declination of the Magnetic Meridian from the True Meridian 6° 30' East. The variation of needle adopted in establishing corners is 6° 30' East.

WITNESS my hand this 20th day of April A. D. 1892.

John Kolar
Peter Allen
 } CHAINMEN.

Charles Sampson SURVEYOR.