


Section's 11 and 13 Township 2 North Range 3 West of 4th P. M.

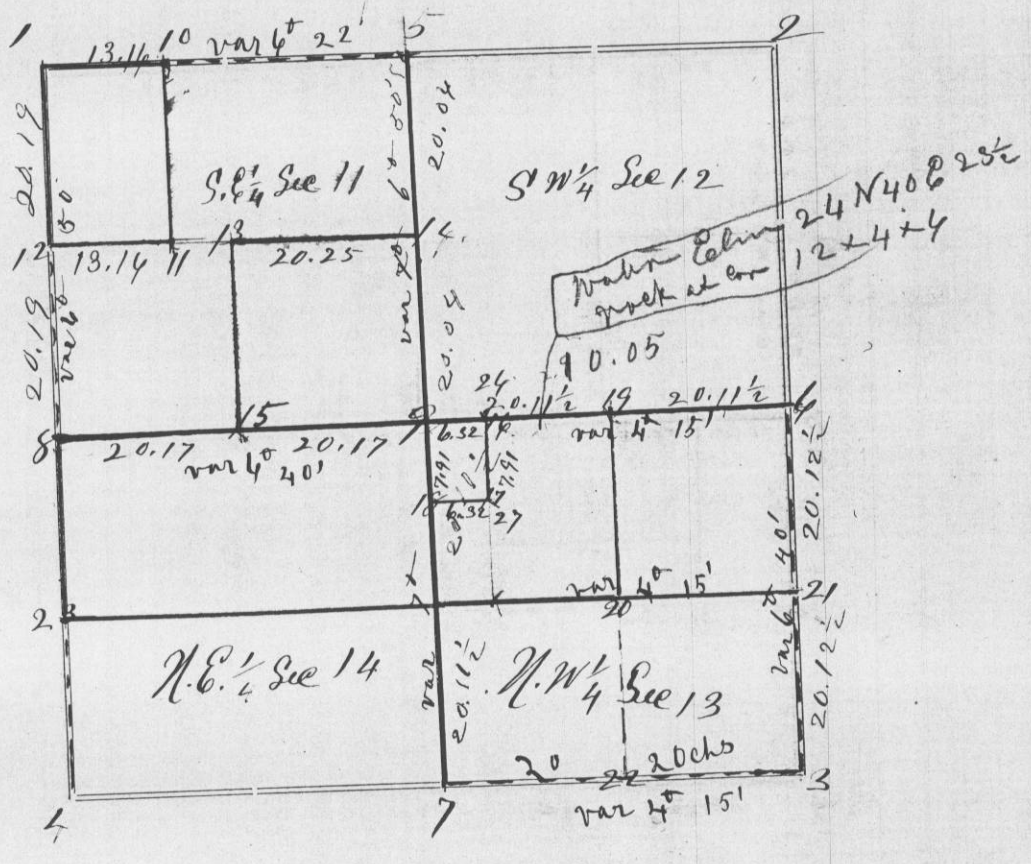

Corners	Bearing Trees	In. Dia.	Courses they Bear	Links Distant	REMARKS
1					Est ablished from 5 and cor by me Fall 1/4 mile west
5					Found roots of old orig trees
6					Stumps of trees still standing Hickory 12 S 77 E 56 Juncagular oak 14 x 12 x 2 N 88 W 50 lks
8					old stake
7					Decayed remains of both orig stumps still extant and B. J.'s taken by Barber
9					Found decayed remains of S.W. tree
8					" " stump tree taken by Barber in 1868
10	Black Oak	8	S 49 W	77	
	" " "	"	S 54 1/2 W	94 1/2	
19	White Oak	8	S 71 1/2 W	41	
	" " "	6	S 49 1/2 W	63 1/2	
26	" " "	10	S 18 E	46 1/2	
	" " "	7	S 67 E	29	
27	Sandstone Boulder		N 14 W	36	
	" " Boulder		N 25 E	47	

CERTIFICATE OF SURVEY.

STATE OF WISCONSIN, } ss.  
GRANT COUNTY,

I, Charles Sampson, County Surveyor in and for the County

and State aforesaid, do hereby certify that I have executed the Survey represented by the foregoing Plat and annexed Field Notes of Survey, in accordance with the State Laws and Instructions of the Commissioner of the General Land Office. Scale, 80 chains to 4 inches. The figures in red ink are the lengths of the lines as stated in the Field Notes of the Government Survey.

Declination of the Magnetic Meridian from the True Meridian 6° 30' East. The variation of needle adopted in establishing corners is East.

WITNESS my hand this 25th day of April A. D. 18 92

Frank Phillips  
Wm. Morisy } CHAINMEN.

Charles Sampson SURVEYOR.