


Section 2 Township 3 North Range 6 West of 4th P. M.

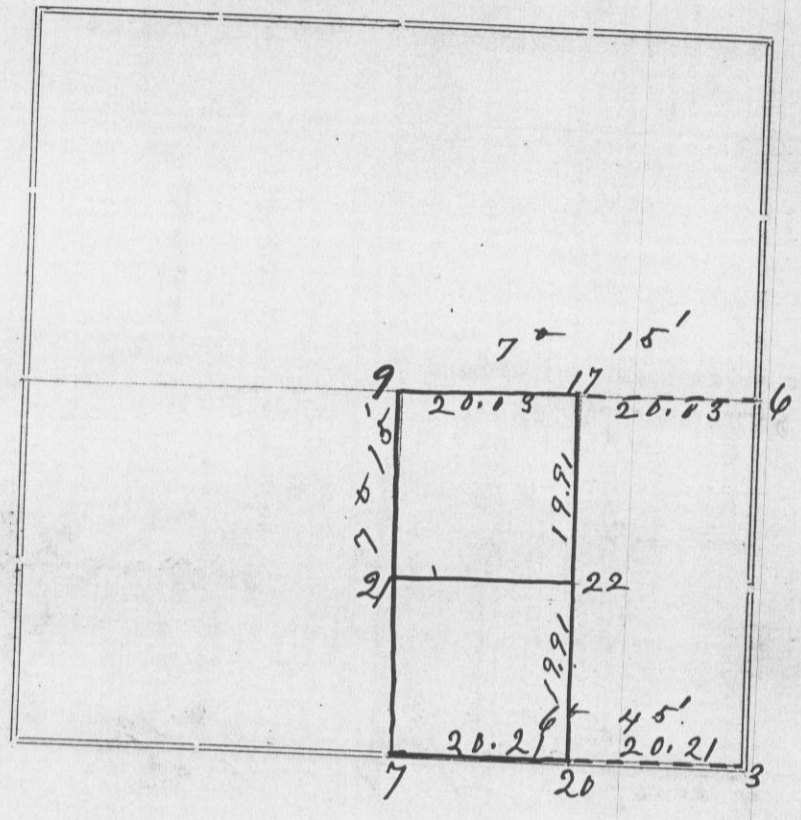

Corners	Bearing Trees	In. Dia.	Courses they Bear	Links Distant	REMARKS
3					Both Orig down. Found Stumps of both
6					One orig still standing. Ancient Stone Cor
7					One orig still standing viz N. W Found Stump of other
9					Established by Overton
17	Sugar	24	N 78 1/2 E	60	
	" "	28	S 11 1/2 W	85	
20	Burr Oak	20	N 58 E	47 1/2	
	" " " "	12	S 73 W	35	
21					Established by Overton
22	Black Walnut	24	S 19 1/2 E	.69	
	elm	28	N 27 1/2 W	1.23	

STATE OF WISCONSIN, } ss.  
GRANT COUNTY,

CERTIFICATE OF SURVEY.

I, Charles Sampson, County Surveyor in and for the County and State aforesaid, do hereby certify that I have executed the Survey represented by the foregoing Plat and annexed Field Notes of Survey, in accordance with the State Laws and Instructions of the Commissioner of the General Land Office. Scale, 80 chains to 4 inches. The figures in red ink are the lengths of the lines as stated in the Field Notes of the Government Survey.

Declination of the Magnetic Meridian from the True Meridian 6° 30' East. The variation of needle adopted in establishing corners is 7° 15' East.

WITNESS my hand this 9th day of May A. D. 1894.

Charles Sampson  
Louis San } CHAINMEN.

Charles Sampson SURVEYOR.