


Section 29, 30, 31 Township 3 North Range 4 West of 4th P. M.

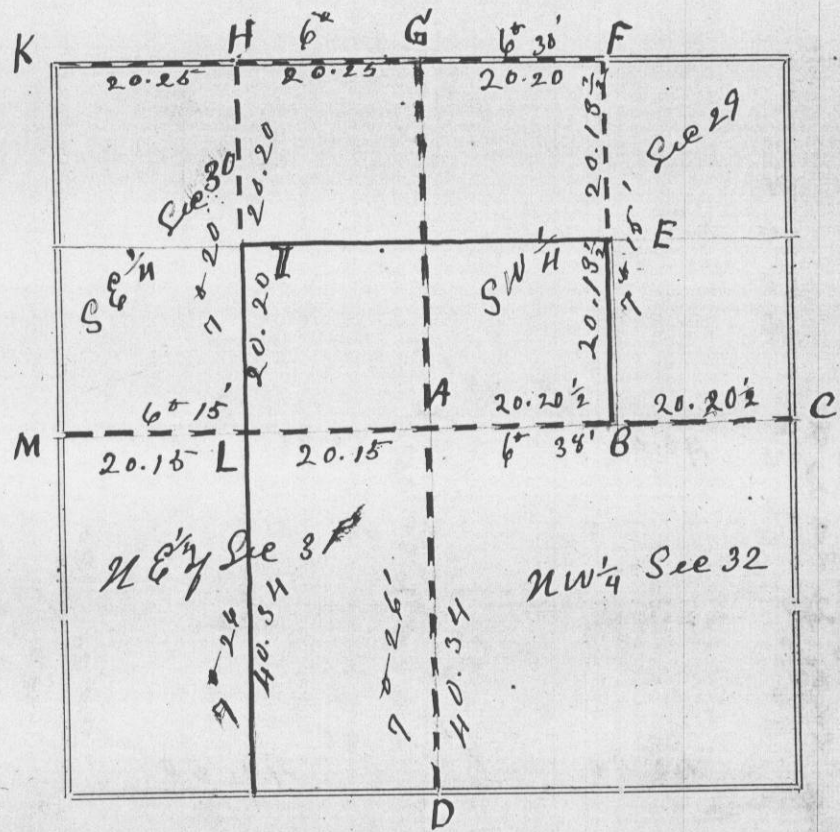

Corners	Bearing Trees	In. Dia.	Courses they Bear	Links Distant	REMARKS
A					Found stumps of both original Blk Walnut still standing
B	White Oak Cherry	5 5	N 41 W N 41 1/4 W	33 45	
C					Found Remains of both original B.F.S. Also so of posts
D					One B.F. still standing and stump of the other
E	Pr Oak " " "	2 3	S 39 1/2 W N 58 E	15 1/2 20	
F					Established by witness
G					Stump of one original extant
K					Found stumps of both original B.F.S
H	Red Oak Blk Stump	24 24	N 41 1/2 E N 40 E	41 5	
M					Found stumps of both orig B.F.S

CERTIFICATE OF SURVEY.

STATE OF WISCONSIN, } ss.
 GRANT COUNTY, }

I, _____, County Surveyor in and for the County and State aforesaid, do hereby certify that I have executed the Survey represented by the foregoing Plat and annexed Field Notes of Survey, in accordance with the State Laws and Instructions of the Commissioner of the General Land Office. Scale, 80 chains to 4 inches. The figures in red ink are the lengths of the lines as stated in the Field Notes of the Government Survey.

Declination of the Magnetic Meridian from the True Meridian _____ East. The variation of needle adopted in establishing corners is _____ East.

WITNESS my hand this _____ day of _____ A. D. 18 _____

John Steffen } CHAINMEN.
Wm Anderson }

_____ SURVEYOR.