


Section 16 Township 5-North Range 3 West of 4th P. M.

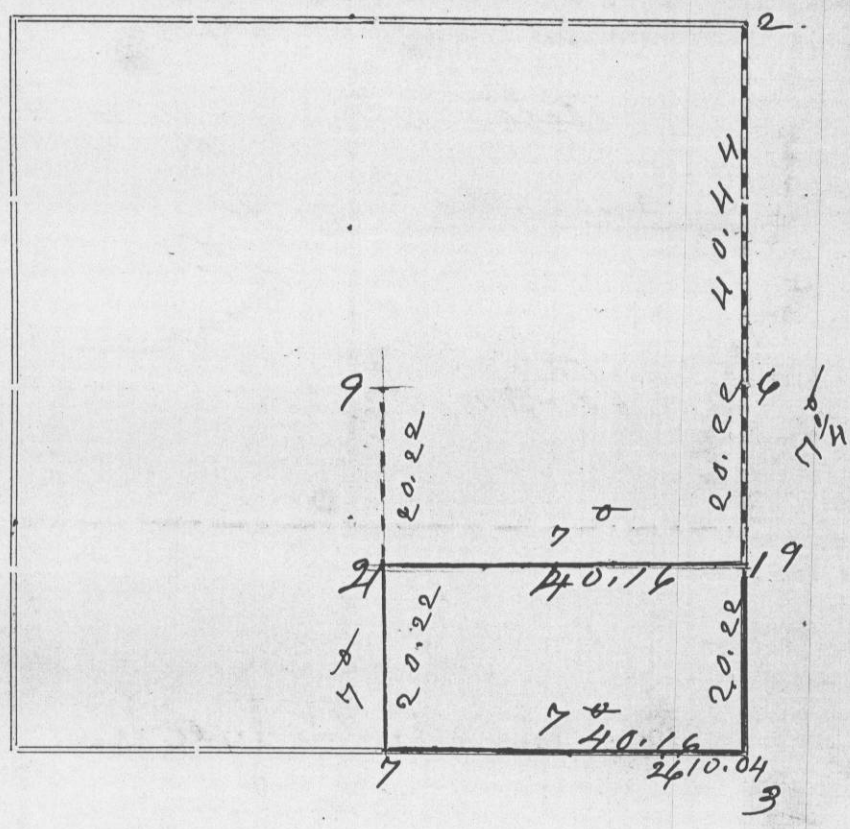

Corners	Bearing Trees	In. Dia.	Courses they Bear	Links Distant	REMARKS
2	NW original still standing				
3	Found remains of both original Black Oak 20		S 82 1/2 E	49 2	rem NW 1/4 N 23 1/2 E 48
	White " " 12		N 2 W	108	
19	Burr Oak 12		S 47 1/2 W	89	
	Black " " 20		S 14 W	75	
26	Black oak 20		N 67 1/2 W	12 1/2	
	" " " " 20		S 48 W	24 1/2	
	" " " " 6		" " "	18 1/2	

CERTIFICATE OF SURVEY.

STATE OF WISCONSIN, } ss.
 GRANT COUNTY, }
 I, _____, County Surveyor in and for the County and State aforesaid, do hereby certify that I have executed the Survey represented by the foregoing Plat and annexed Field Notes of Survey, in accordance with the State Laws and Instructions of the Commissioner of the General Land Office. Scale, 80 chains to 4 inches. The figures in red ink are the lengths of the lines as stated in the Field Notes of the Government Survey.
 Declination of the Magnetic Meridian from the True Meridian _____ East. The variation of needle adopted in establishing corners is _____ East.
 WITNESS my hand this _____ day of _____ A. D. 18 _____

_____ } CHAINMEN.
 _____ } SURVEYOR.