


Section 5 Township 5 North Range 5 West of 4th P. M.

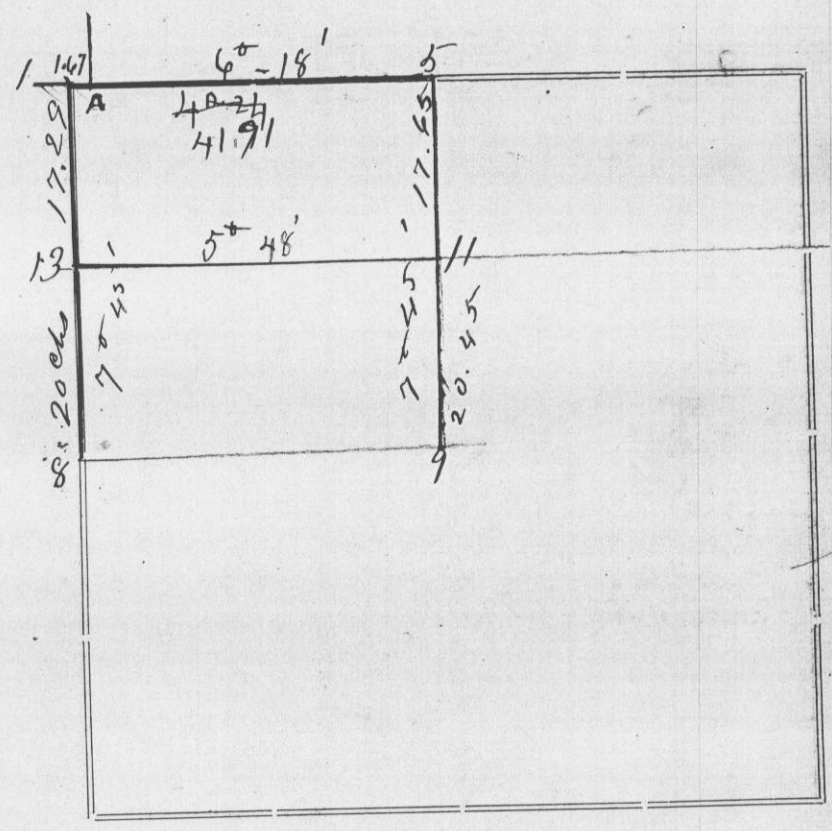

Corners	Bearing Trees	In. Dia.	Courses they Bear	Links Distant	REMARKS
A	Black Oak Bunch of 3 Brookes	16 3	N 5 W N 54 1/2 E	45 265	Found remains of both bearing trees
1	Put in rock				Found remains of both Original B. T. s
5					Found Stumps of both Originals
8					" " " " "
9					Put in by Appleby
11	Put in Stone Burr Oak	12 10	N 27 E N 12 W	70 122	
13	Castorwood Tree Rock at corner	30	S 16 E N 45 E	306 110	

CERTIFICATE OF SURVEY.

STATE OF WISCONSIN, }  
GRANT COUNTY, } ss.

I, Charles Sampson, County Surveyor in and for the County

and State aforesaid, do hereby certify that I have executed the Survey represented by the foregoing Plat and annexed Field Notes of Survey, in accordance with the State Laws and Instructions of the Commissioner of the General Land Office. Scale, 80 chains to 4 inches. The figures in red ink are the lengths of the lines as stated in the Field Notes of the Government Survey,

Declination of the Magnetic Meridian from the True Meridian 6° 36' East. The variation of needle adopted in establishing corners is 7 East.

WITNESS my hand this 2<sup>nd</sup> day of July A. D. 18. 94.

Frank Hill  
Frank Hill } CHAINMEN.

Charles Sampson SURVEYOR