


Section 18 Township \_\_\_\_\_ North Range 3 West of 4th P. M.

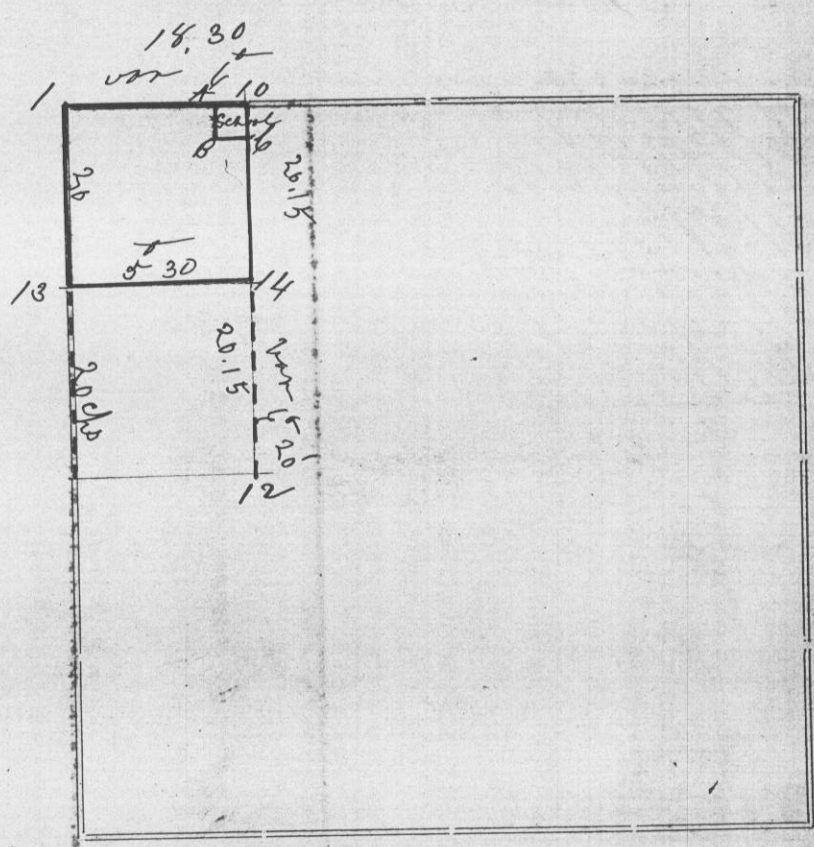

Corners	Bearing Trees	In. Dia.	Courses they Bear	Links Distant	REMARKS
1	Stake and rock Hickory Bullhead	6 10	Good evidence of adjacent Harrison cor S 25 E	76 65	} new
10	Rock set by Denton				
12	" " "	" "	" "		Also found remains of his bearing lines
13	Burr Oak White oak	16 12	N 41 E N 67 1/2 E	122 99	
14	White Oak Red Oak	16 12	N 24 1/2 W N 44 W	46 63	
A B C	Set Stone " " " " " "				Description of School lot viz: 10 to A 3 1/4 chs A to B Do Do B to C 81 00 C to 10 80 00  Can't running 1 acre

CERTIFICATE OF SURVEY.

STATE OF WISCONSIN, } ss.  
 GRANT COUNTY, }  
 I, Charles Sampson, County Surveyor in and for the County and State aforesaid, do hereby certify that I have executed the Survey represented by the foregoing Plat and annexed Field Notes of Survey, in accordance with the State Laws and Instructions of the Commissioner of the General Land Office. Scale, 80 chains to 4 inches. The figures in red ink are the lengths of the lines as stated in the Field Notes of the Government Survey.

Declination of the Magnetic Meridian from the True Meridian 2.0 East. The variation of needle adopted in establishing corners is 7 East.

WITNESS my hand this 16<sup>th</sup> day of April A. D. 18 98.

James Loring } CHAINMEN.  
McNeill Brown }

C. C. Sampson SURVEYOR.