


Section 6 Township North Range 2 West of 4th P. M.

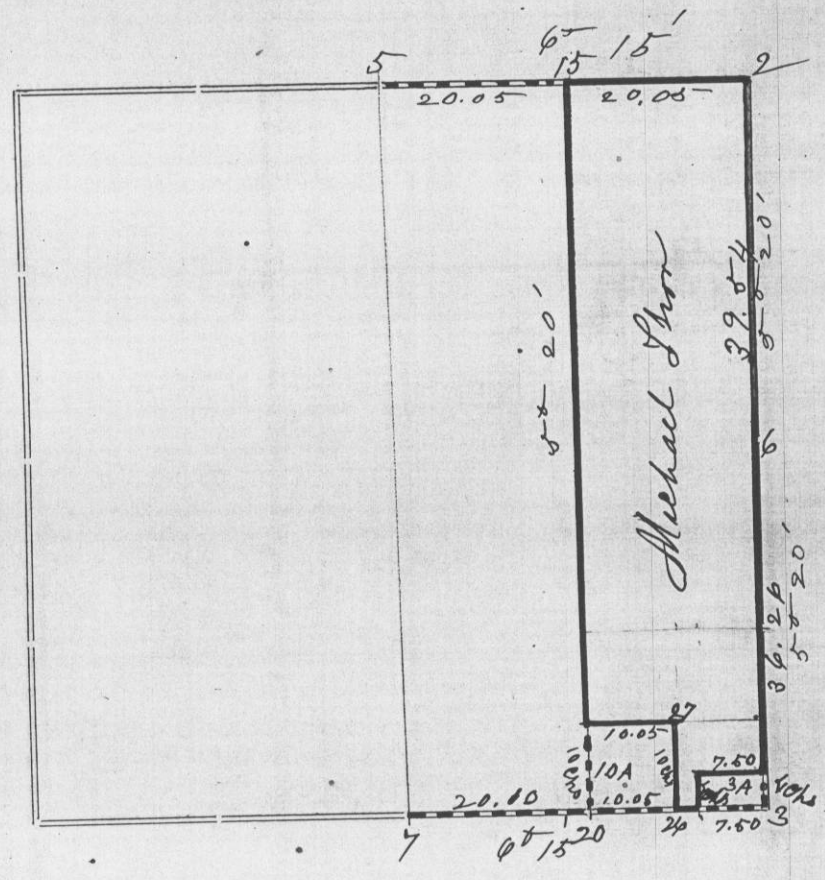

Corners	Bearing Trees	In. Dia.	Courses they Bear	Links Distant	REMARKS
2					Old established corner. Witness gone
5					" " " " " " " "
8					" " " " " " " "
7					Found rem. ends of both ^{original} witness trees and a stake set by Sect. Co. Surveyor
6					Found rem. ends of both original witness trees
26	Burr Oak "Set Stone"	8 7	N 34 1/2° E S 46 1/4° E	42 40	

CERTIFICATE OF SURVEY.

STATE OF WISCONSIN, } ss.
 GRANT COUNTY, }
 I, Charles Sampson, County Surveyor in and for the County and State aforesaid, do hereby certify that I have executed the Survey represented by the foregoing Plat and annexed Field Notes of Survey, in accordance with the State Laws and Instructions of the Commissioner of the General Land Office. Scale, 80 chains to 4 inches. The figures in red ink are the lengths of the lines as stated in the Field Notes of the Government Survey.
 Declination of the Magnetic Meridian from the True Meridian 6° 25' East. The variation of needle adopted in establishing corners is 7' East.
 WITNESS my hand this 29th day of August A. D. 1898.
Wm. K. K. Jr.
Wm. K. K. Jr. } CHAINMEN.
Charles Sampson SURVEYOR.