


Section 23 Township 3 North Range 4 West of 4th P. M.

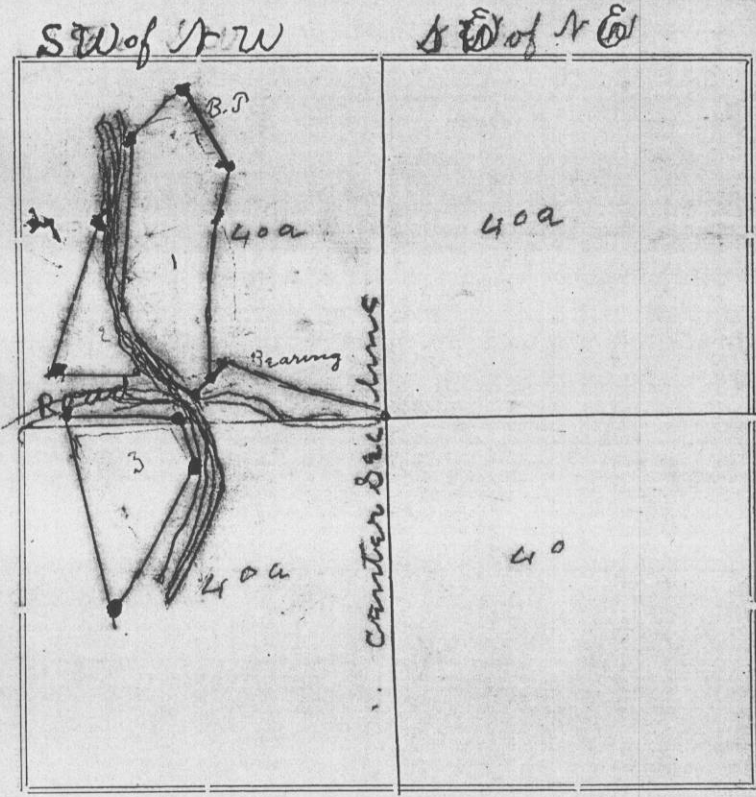

Morgan Road

Corners	Bearing Trees	In. Dia.	Courses they Bear	Links Distant	REMARKS
	Box Alder	4	N 2.30	69	Run from center sec cor N 70° 24' W 809 l Thomas to
	Tying of Bridge		S 64 1/2 E	121	630 m W 6 chs + 33 l Then S 59° 15' min W 84 l to place of beginning Then N 1° 15' min W 5 1/2 l Then N 3° 30' E 26 1/2 l then N 63° 00' W 194 l then N 35° W 226 l at this is a marking Tree Box Alder 4 N 78° E 69 l Then South 59° W 247 l Then S 34° W 682 l Then S 4° 15' E 101 l Then S 24° E 247 l Then S 51° E 123 l Then S 72° E 48 l to place of beginning at this point is Tying of Bridge for leading to cor S 68 1/2 E 12 The beginning of lot 2 at S E cor then S 63° W 346 l Then N 54° W 527 l Then S 3 1/2° E 232 l Then 49° E 380 l to beginning Beginning of lot 3 Then south 24° W 467 l Then 36° W 45 l then N 52 1/2° W 181 l then S 78° E 333 l then S 62° E 82 l

CERTIFICATE OF SURVEY.

STATE OF WISCONSIN, }  
 GRANT COUNTY, } ss.

I, A. H. Appleby, County Surveyor in and for the County

and State aforesaid, do hereby certify that I have executed the Survey represented by the foregoing Plat and annexed Field Notes of Survey, in accordance with the State Laws and Instructions of the Commissioner of the General Land Office. Scale, 80 chains to 4 inches. The figures in red ink are the lengths of the lines as stated in the Field Notes of the Government Survey.

Declination of the Magnetic Meridian from the True Meridian ..... East. The variation of needle adopted in establishing corners is ..... East.

WITNESS my hand this ..... day of ..... A. D. 18.....

..... } CHAINMEN. A. H. Appleby SURVEYOR.