


Section 7 Township 6 North Range 3 West of 4th P. M.

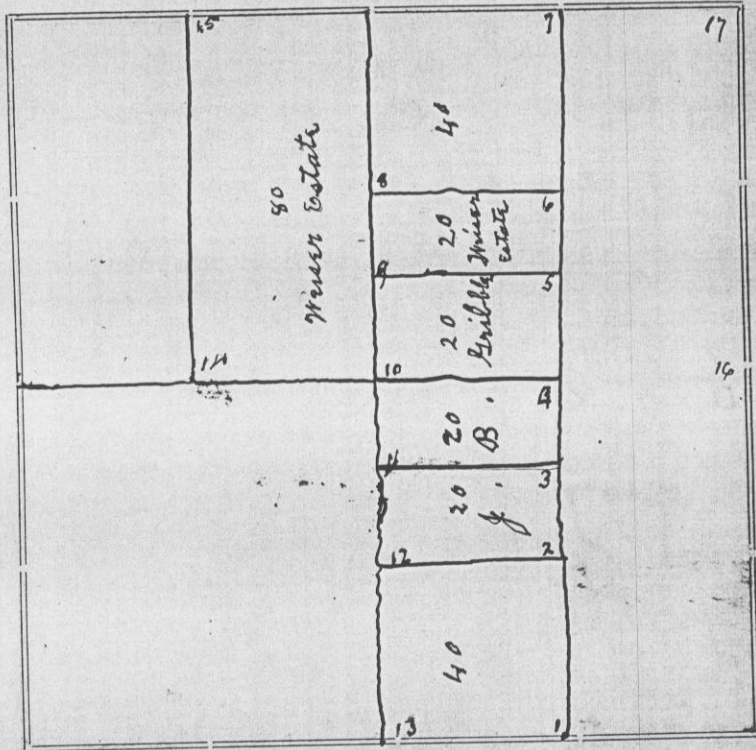

For J. B. Griffith, F. Wasser and R. B. Campbell

Corners	Bearing Trees	In. Dia.	Courses they Bear	Links Distant	REMARKS
1 Stakes					This recorded as by my correction of same and as it now is
2 "					
3 "					
4 "					
5 "					
6 "					
7 "					
8 "					
9 "					
10 "					
11 "					
12 "					
13 "					
14 " and 15 Stakes & 16 Stone 17 Stakes					

CERTIFICATE OF SURVEY.

STATE OF WISCONSIN, } ss.  
GRANT COUNTY,

I, A. W. Applegate, County Surveyor in and for the County and State aforesaid, do hereby certify that I have executed the Survey represented by the foregoing Plat and annexed Field Notes of Survey, in accordance with the State Laws and Instructions of the Commissioner of the General Land Office. Scale, 80 chains to 4 inches. The figures in red ink are the lengths of the lines as stated in the Field Notes of the Government Survey.

Declination of the Magnetic Meridian from the True Meridian 6 East. The variation of needle adopted in establishing corners is East.

WITNESS my hand this 25<sup>th</sup> day of Oct A. D. 1929

Jesse Campbell  
F. Wasser } CHAINMEN.

A. W. Applegate SURVEYOR.