


1-6-4

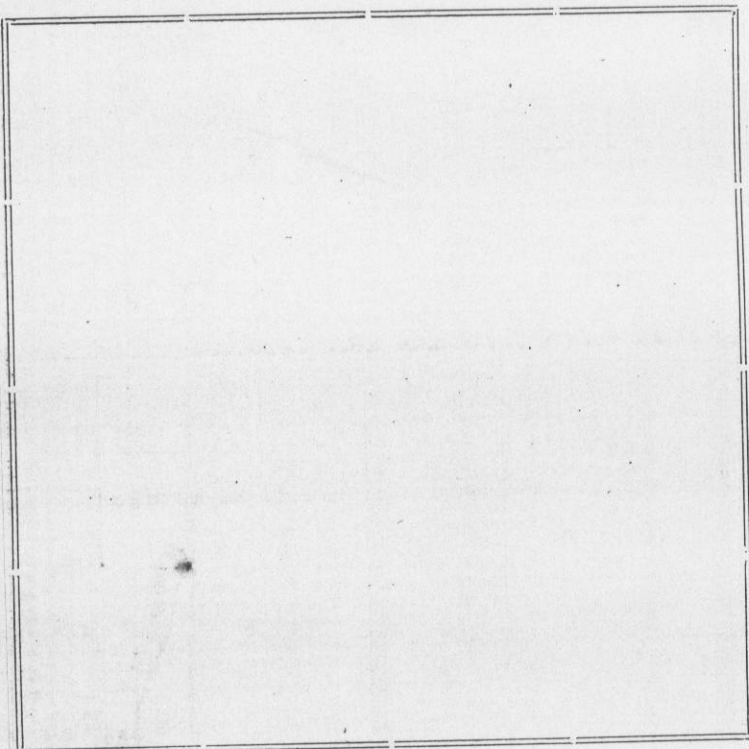

John Conroy + A. B. Campbell

Corners	Bearing Trees	In. Dia	Courses they Bear	Links Distant	REMARKS
					Beginning 38 rods East of $\frac{1}{8}$ cor through center of Sec on South side of N $\frac{1}{4}$ of Sec 1 T 6 R 4 West of 4 <sup>th</sup> Mer
					Thence N 7 $\frac{1}{2}$ E 16 rods Thence N 56 W 1 $\frac{1}{4}$ rods
					" " 62 $\frac{1}{2}$ W 9 rods
					" " 58 " 20 "
					" " 32 " 7 "
					" " 44 rods + 8 l
					" East to place of beginning
					From same place of Beginning S 7 W 9 rods + 8 l
					Then South 55 W 23 rods
					" " 28 " 13 " 13 l
					" " 1 E 3 " 13 l
					" " 28 " 4 "
					" " 33 $\frac{1}{2}$ " 10 "
					" " 45 " 13 " 14 l
					" " 9 " 16 " 14 l 1193 last
					" " " 11 " 9 l
					" " 30 W 12 " 8 l
					Thence E on line 5 " 17 l
					Then on line 20 rods through Sec Stake at each angle.

CERTIFICATE OF SURVEY.

STATE OF WISCONSIN, } ss.  
 GRANT COUNTY, }  
 I, A. W. Appleby, County Surveyor in and for the County and State aforesaid, do hereby certify that I have executed the Survey represented by the foregoing Plat and annexed Field Notes of Survey, in accordance with the State Laws and Instructions of the Commissioner of the General Land Office. Scale, 80 chains to 4 inches. The figures in red ink are the lengths of the lines as stated in the Field Notes of the Government Survey.

Declination of the Magnetic Meridian from the True Meridian ..... East. The variation of needle adopted in establishing corners is ..... East.

WITNESS my hand this 27 day of Oct A. D. 1909

..... } CHAINMEN. A. W. Appleby SURVEYOR.