


HILLARY SURVEY

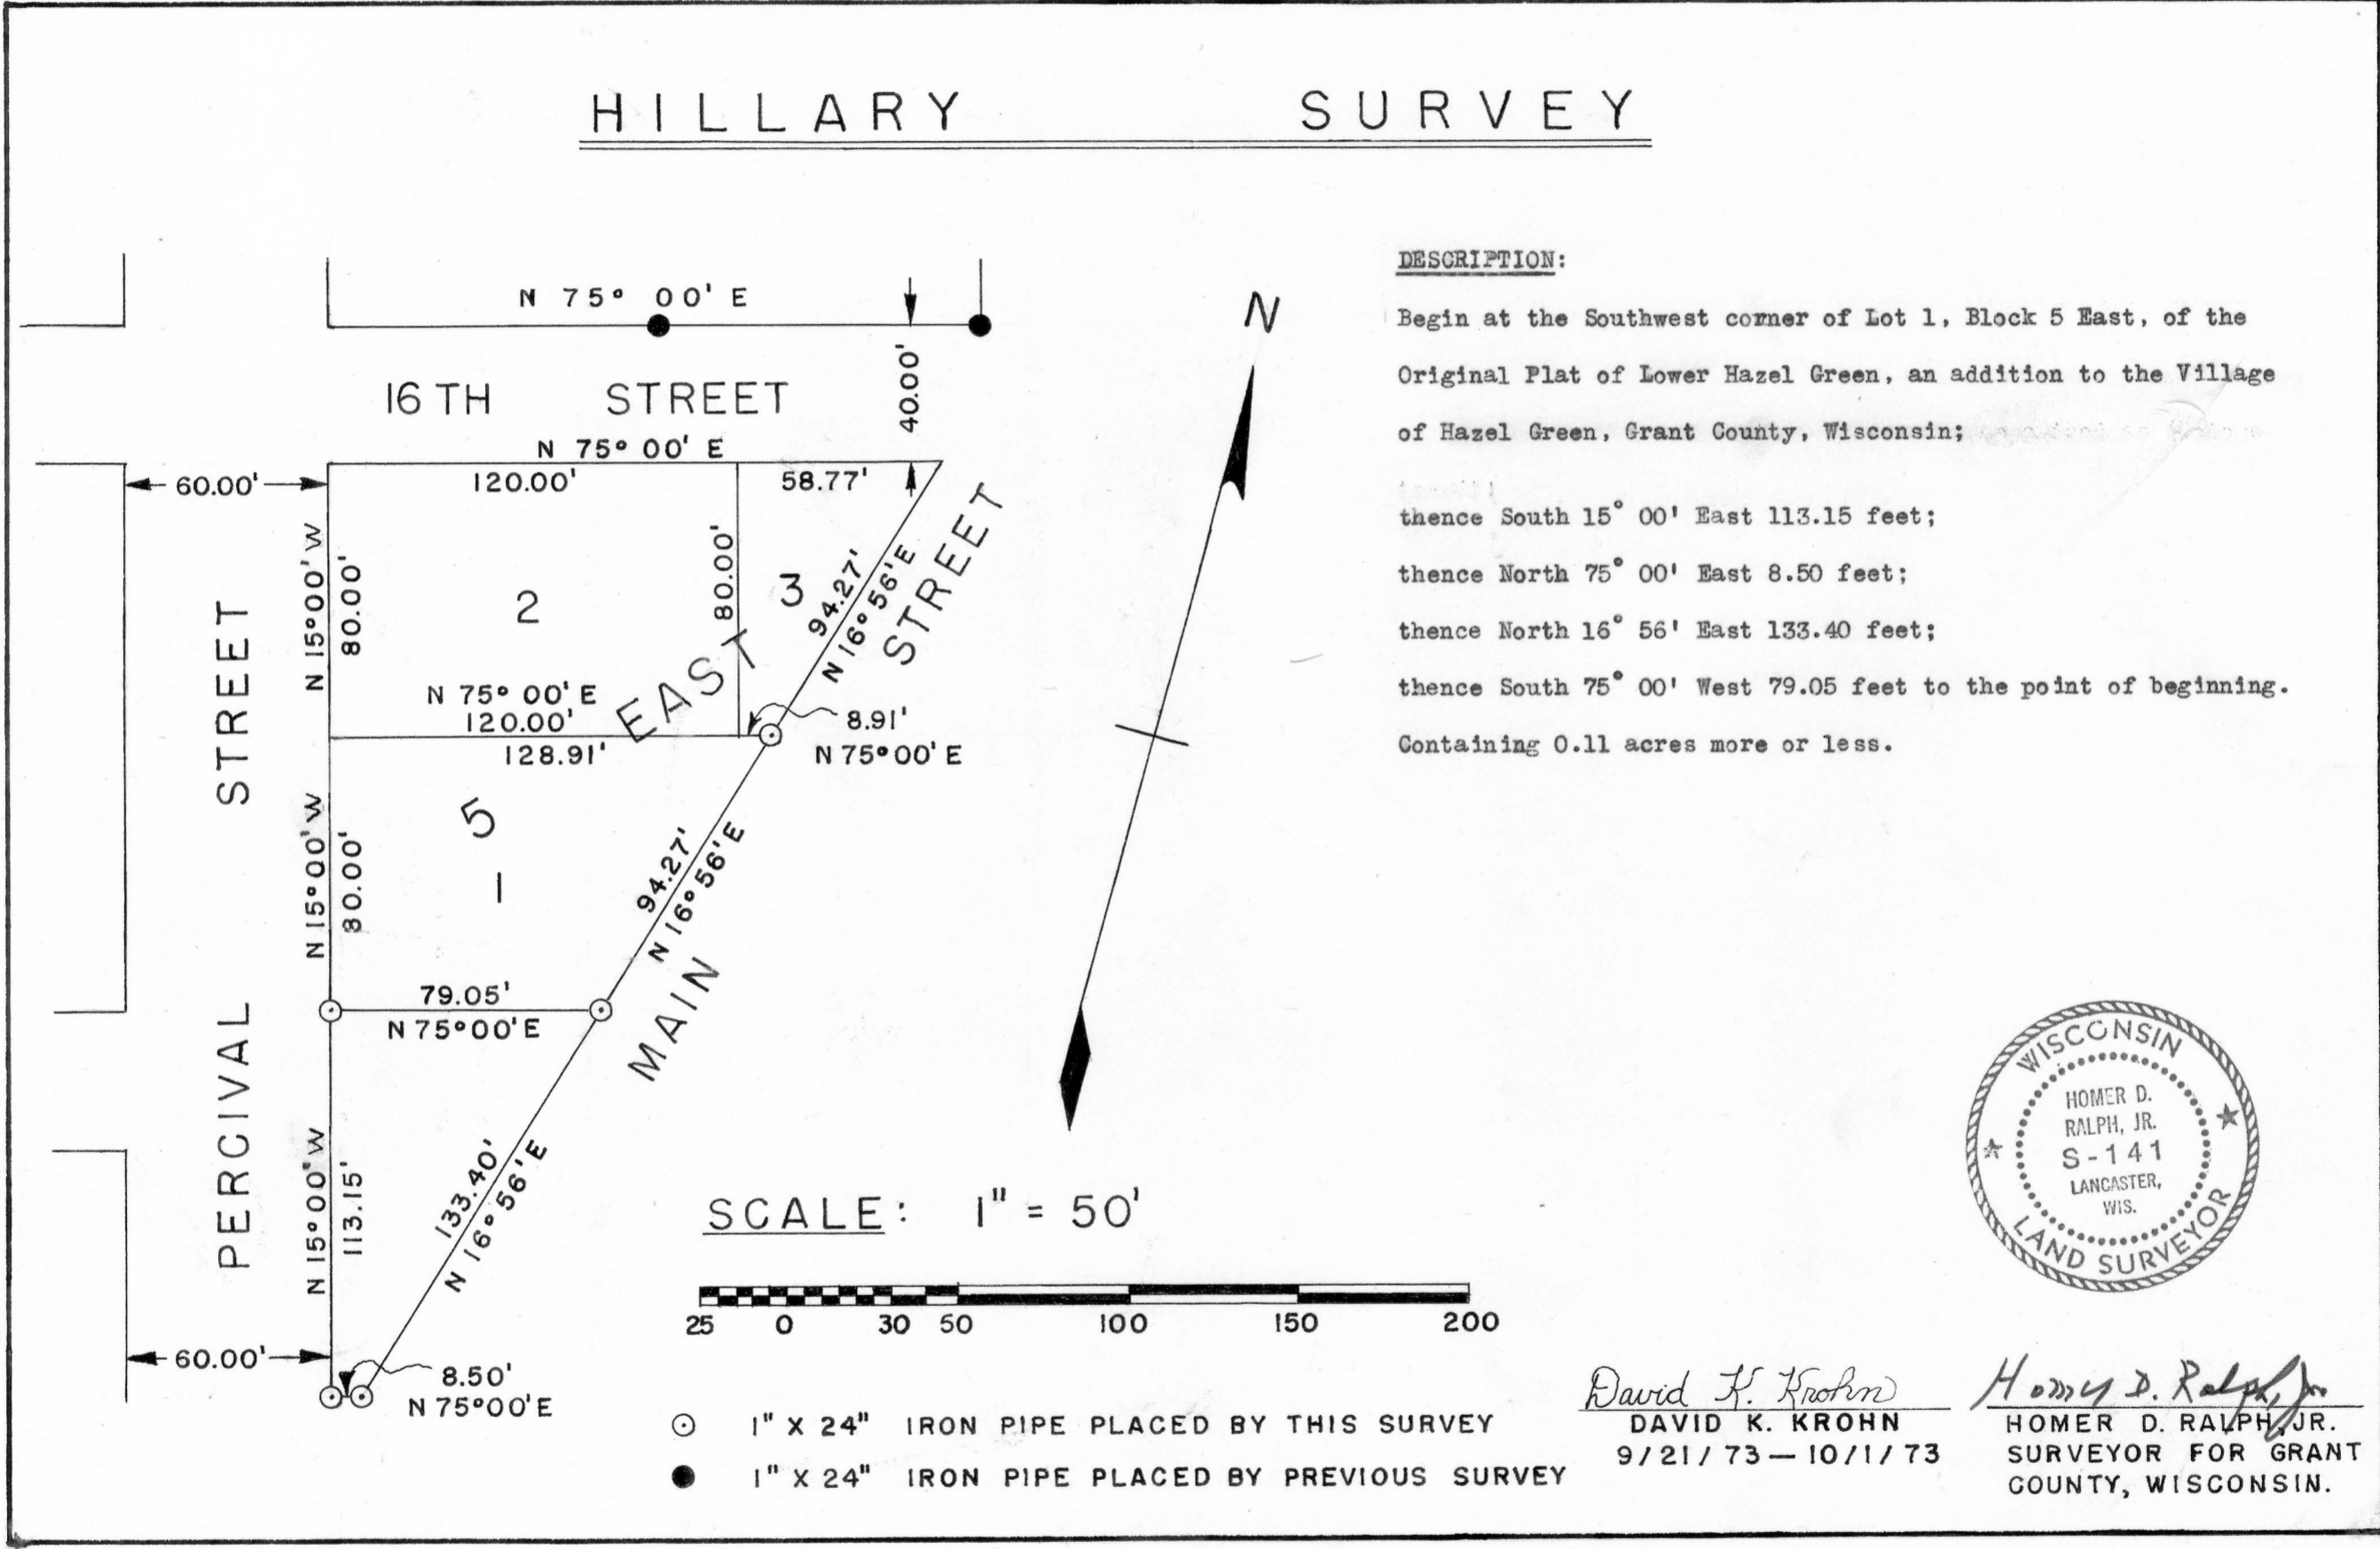

DESCRIPTION:
 Begin at the Southwest corner of Lot 1, Block 5 East, of the Original Plat of Lower Hazel Green, an addition to the Village of Hazel Green, Grant County, Wisconsin;
 thence South 15° 00' East 113.15 feet;
 thence North 75° 00' East 8.50 feet;
 thence North 16° 56' East 133.40 feet;
 thence South 75° 00' West 79.05 feet to the point of beginning.
 Containing 0.11 acres more or less.



David K. Krohn
 DAVID K. KROHN
 9/21/73 - 10/1/73

Homer D. Ralph, Jr.
 HOMER D. RALPH, JR.
 SURVEYOR FOR GRANT COUNTY, WISCONSIN.