


MAP OF
HILLCREST CEMETERY
for
MONTFORT CEMETERY Assoc.

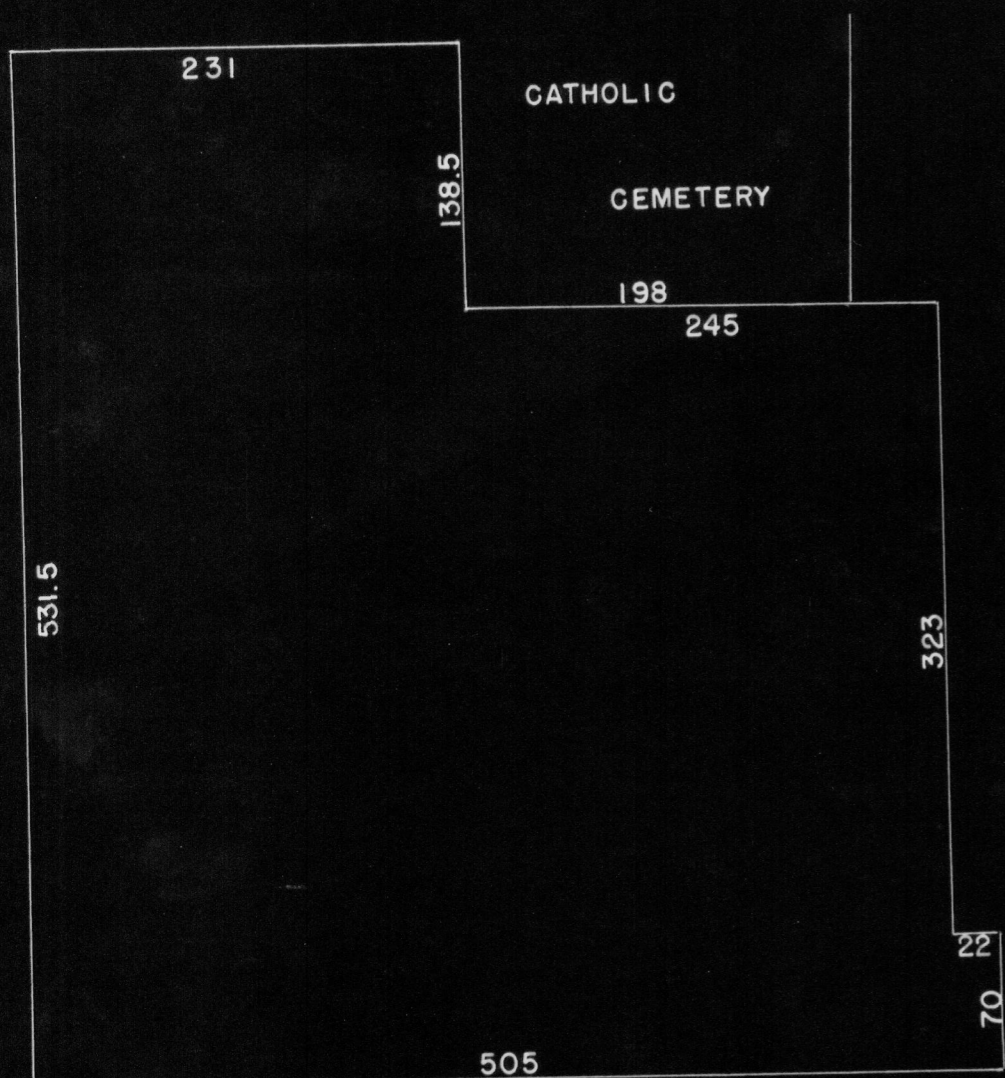

Homer D. Ralph, Jr.
Homer D. Ralph, Jr., Surveyor
for Grant Co., Wis. 9/22/53

SW. Cor. of S.E.1/4 of S.E.1/4 in
Sec. 24, T6N, R1W., Grant Co., Wis.

DESCRIPTION OF MONTFORT CEMETERY

Commence at a point which is 290 feet North of the Southwest corner of the S.E.1/4 of the S.E.1/4 of Sec. 24, T 6 N, R 1 W. of the 4th P.M. in Grant County, Wisconsin, thence North 531.5 feet, thence East 231 feet, thence South 138.5 feet, thence East 245 feet, thence South 323 feet, thence East 22 feet, thence South 70 feet, thence West 505 feet to the place of beginning.

