


HODACH SURVEY

8-1

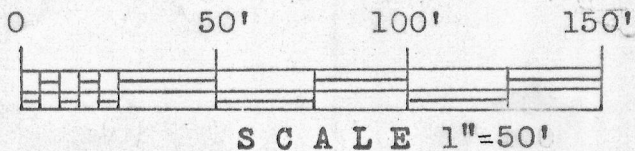

⊕ 1"x24" iron pipe placed by this survey.

W ——— E

BEACH

STREET

60½'

70'

70'

EAST

LOT 16

LOT 15

LOT 14

LOT 14

NORTH

STREET

60½'

20'

140'

50'

50'

75'

75'

25'

25'

B L O C

2

Description:

Lot 15 and the North 1/2 of Lot 14 in Block 122 of the original plat, Village of Muscoda, Grant County, Wis.

*Thomas S. Bainbridge*  
Thomas S. Bainbridge  
7/6/67-7/11/67

*Homer D. Ralph, Jr.*  
Homer D. Ralph, Jr.  
Surveyor for Grant Co., Wis.  
Wis. Reg. No. S-141

