



BEATRICE LEHMAN SURVEY

8-1

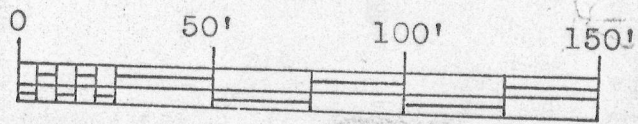

SCALE 1" = 50'

1"x24" iron pipe placed by this survey.

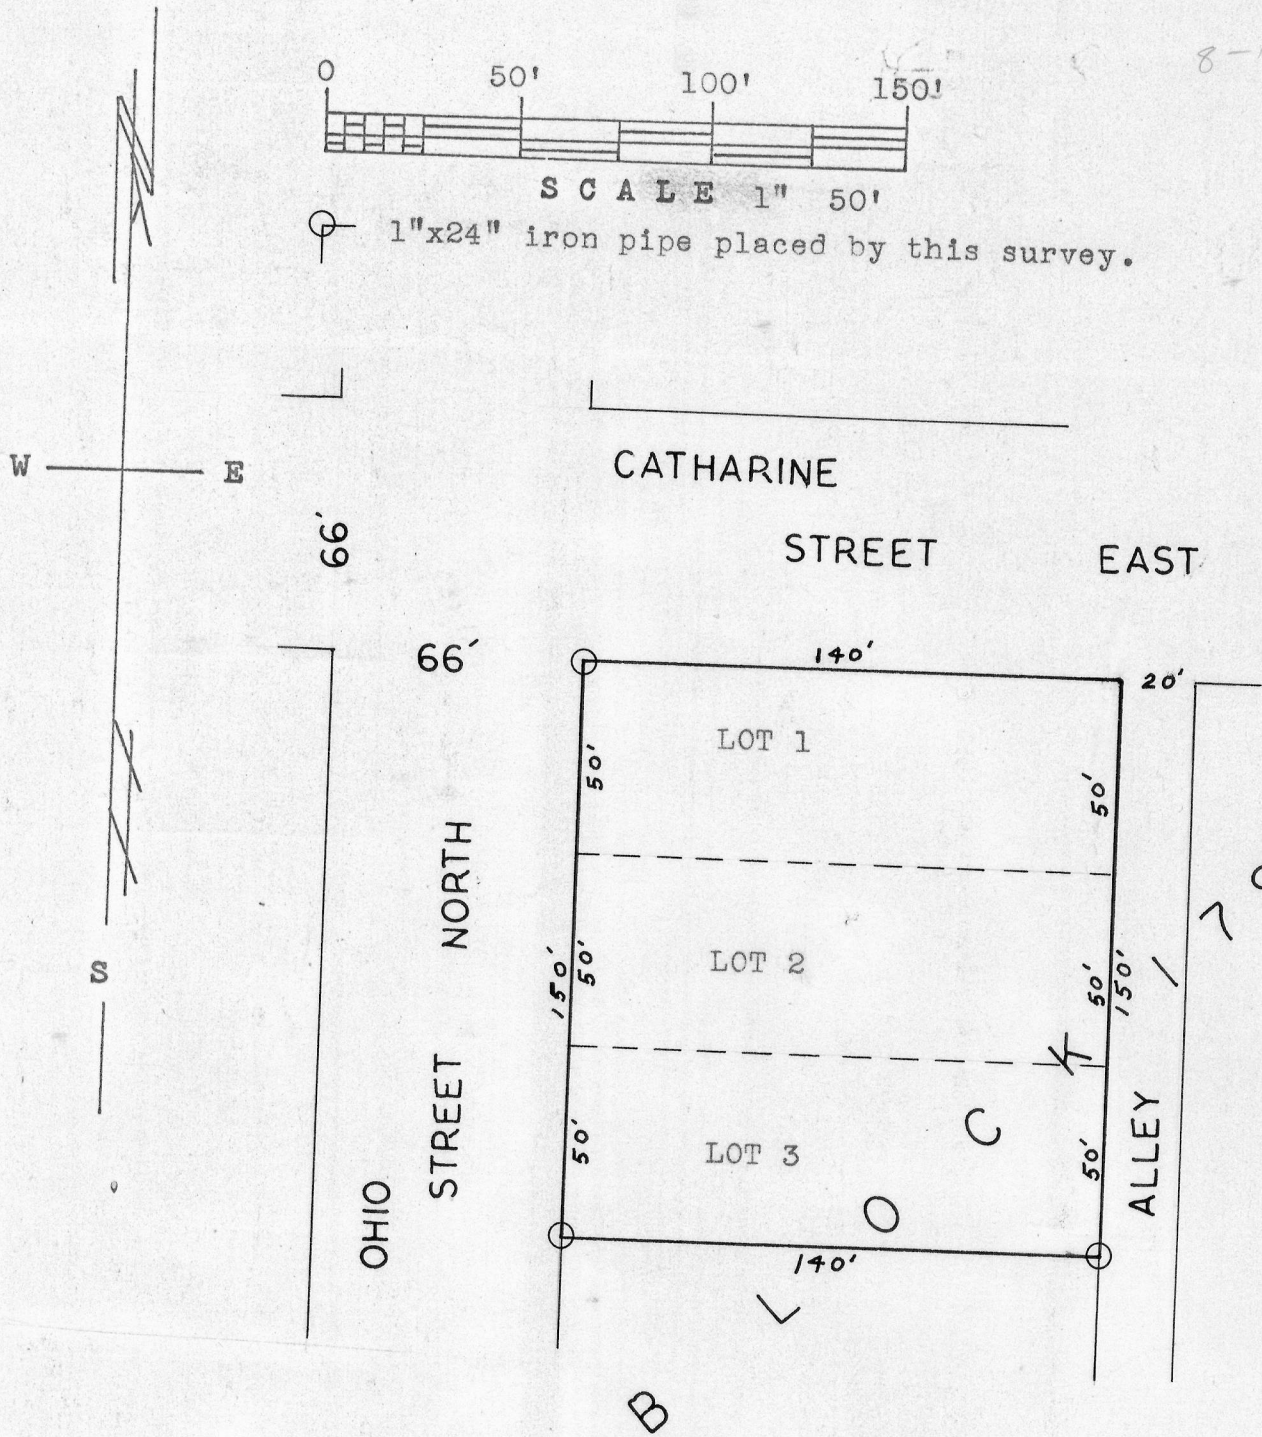

Description:

Lots 1, 2, and 3 in Block 179 according to the O.P. of the Village of Muscoda now vacated.

Thomas S. Bainbridge
 Thomas S. Bainbridge
 7/17/67-7/18/67

Homer D. Ralph, Jr.
 Homer D. Ralph, Jr.
 Surveyor for Grant Co., Wis.
 Wis. Reg. No. S-141