


WALSH SURVEY

8-1

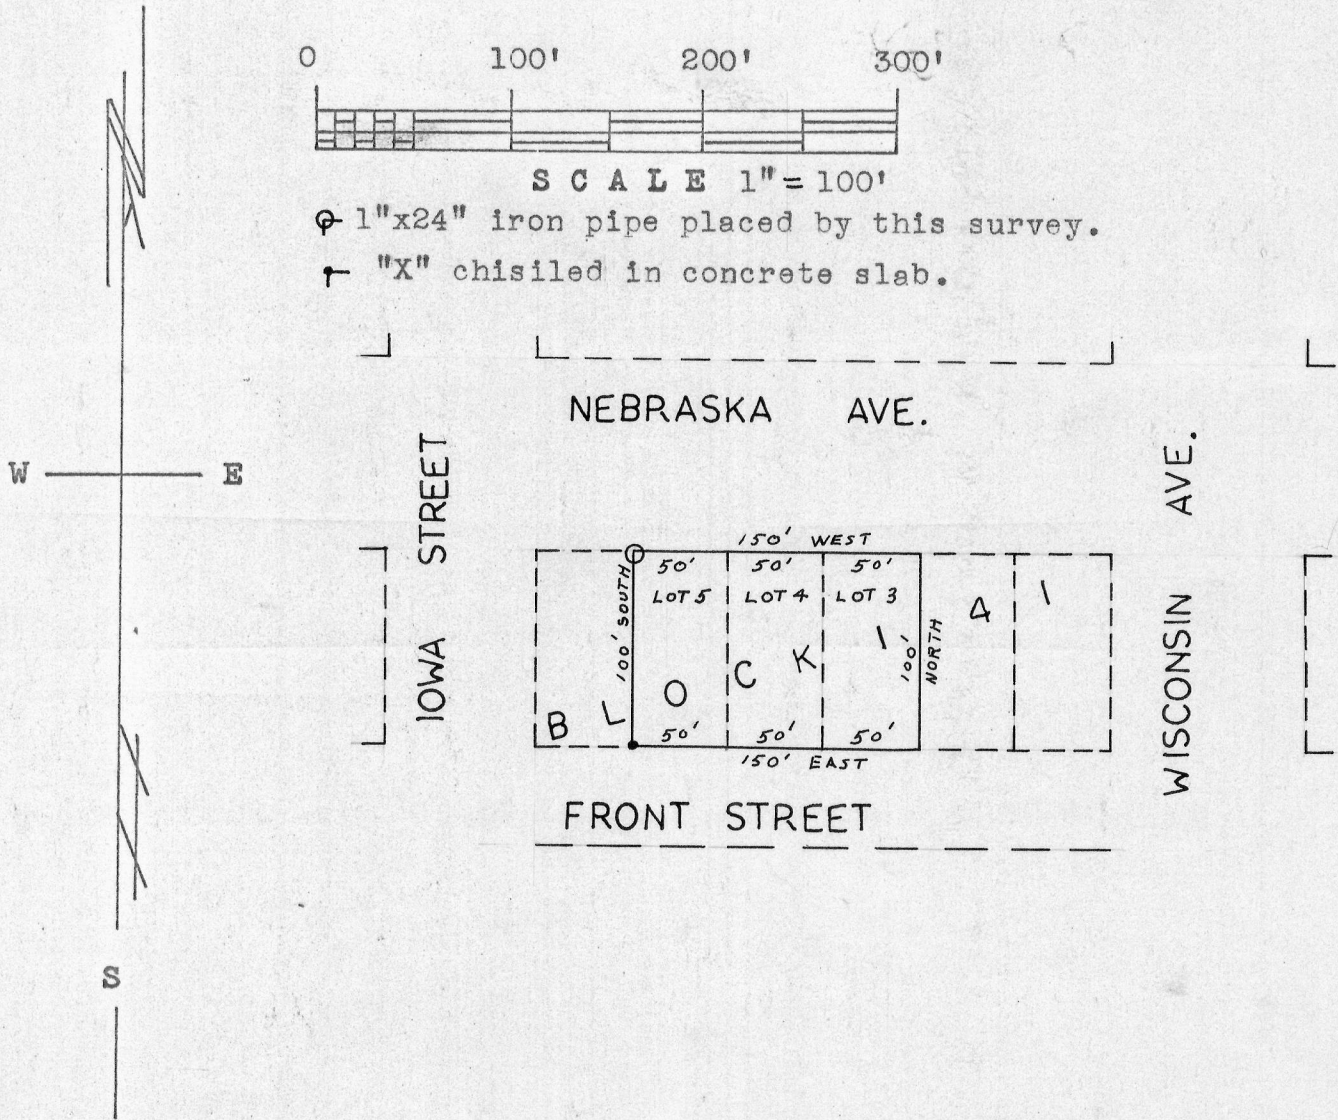

Description:

Lots 3, 4 and 5 in Block 141 of the Original Plat of the Village of Muscoda, Grant County, Wisconsin.

Thomas S. Bainbridge
Thomas S. Bainbridge
7/21/67-7/22/67

Homer D. Ralph, Jr.
Homer D. Ralph, Jr.
Surveyor for Grant Co., Wis.
Wis. Reg. No. S-141