

S.W. COR. OF N.1/2 OF N.E.1/4 OF SEC. 28,
T1N, R2W., OF THE 4TH P.M.
GRANT CO., WIS.

N 06° 43' E
910.8

GENTERLINE OF STATE
TRK. HWY. 35

DESCRIPTION OF LANDS TO BE CONVEYED BY HENRY GILLES AND
JOSEPHINE GILLES TO CYRIL DROESSLER.

A tract of land in the North 1/2 of the N.E.1/4 of Sec.
28, T 1 N - R 2 W. of the 4th P.M. in Grant County,
Wisconsin, described as follows, to-wit:

Commence at a point on the centerline of State Trunk
Highway #35, which is 60 feet more or less East of the
Southwest corner of said North 1/2 of N.E.1/4 of Sec.
28; thence East 1565 feet more or less to a point in
center of Menominee Creek; thence N 23° 04' W. 1032
feet to a cedar tree on top of a bluff; thence
S 87° 32' W. 1072 feet more or less to a point on the
centerline of said Highway; thence S 06° 43' W. 910.8
feet along said centerline to the place of beginning.

State of Wisconsin)
County of Grant) ss


I, Homer D. Ralph, Jr., Surveyor for Grant County, Wisconsin hereby
certify that on the 15th day of December, A.D., 1956, by order and
direction of Henry Gilles and Cyril Droessler I surveyed with the
assistance of Robert W. Lorenz part of the North 1/2 of the N.E.1/4
of Sec. 28, T 1 N, R 2 W. of the 4th P.M. in Grant Co., Wis., and
that this map and the foregoing description are a true and correct
representation of said survey.

Homer D. Ralph, Jr.
Homer D. Ralph, Jr., Surveyor
for Grant Co., Wis.,
Wis. Reg. No. S-141
12/15/56 1/11/57

CEDAR TREE ON
TOP OF BLUFF

S 87° 32' W 1072

N 23° 04' W
1032

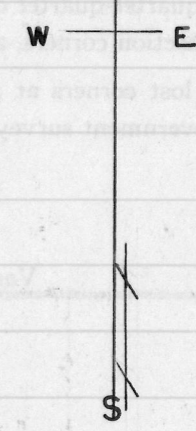

CENTER OF
MENOMINEE
CREEK