
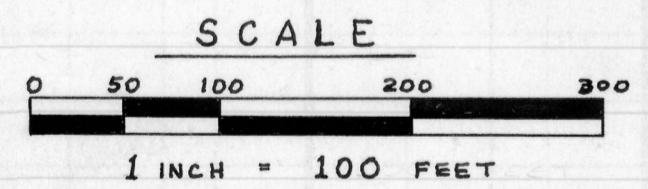
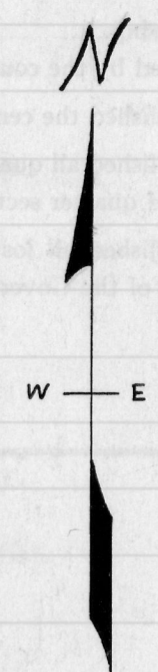


# DUNN - SURVEY

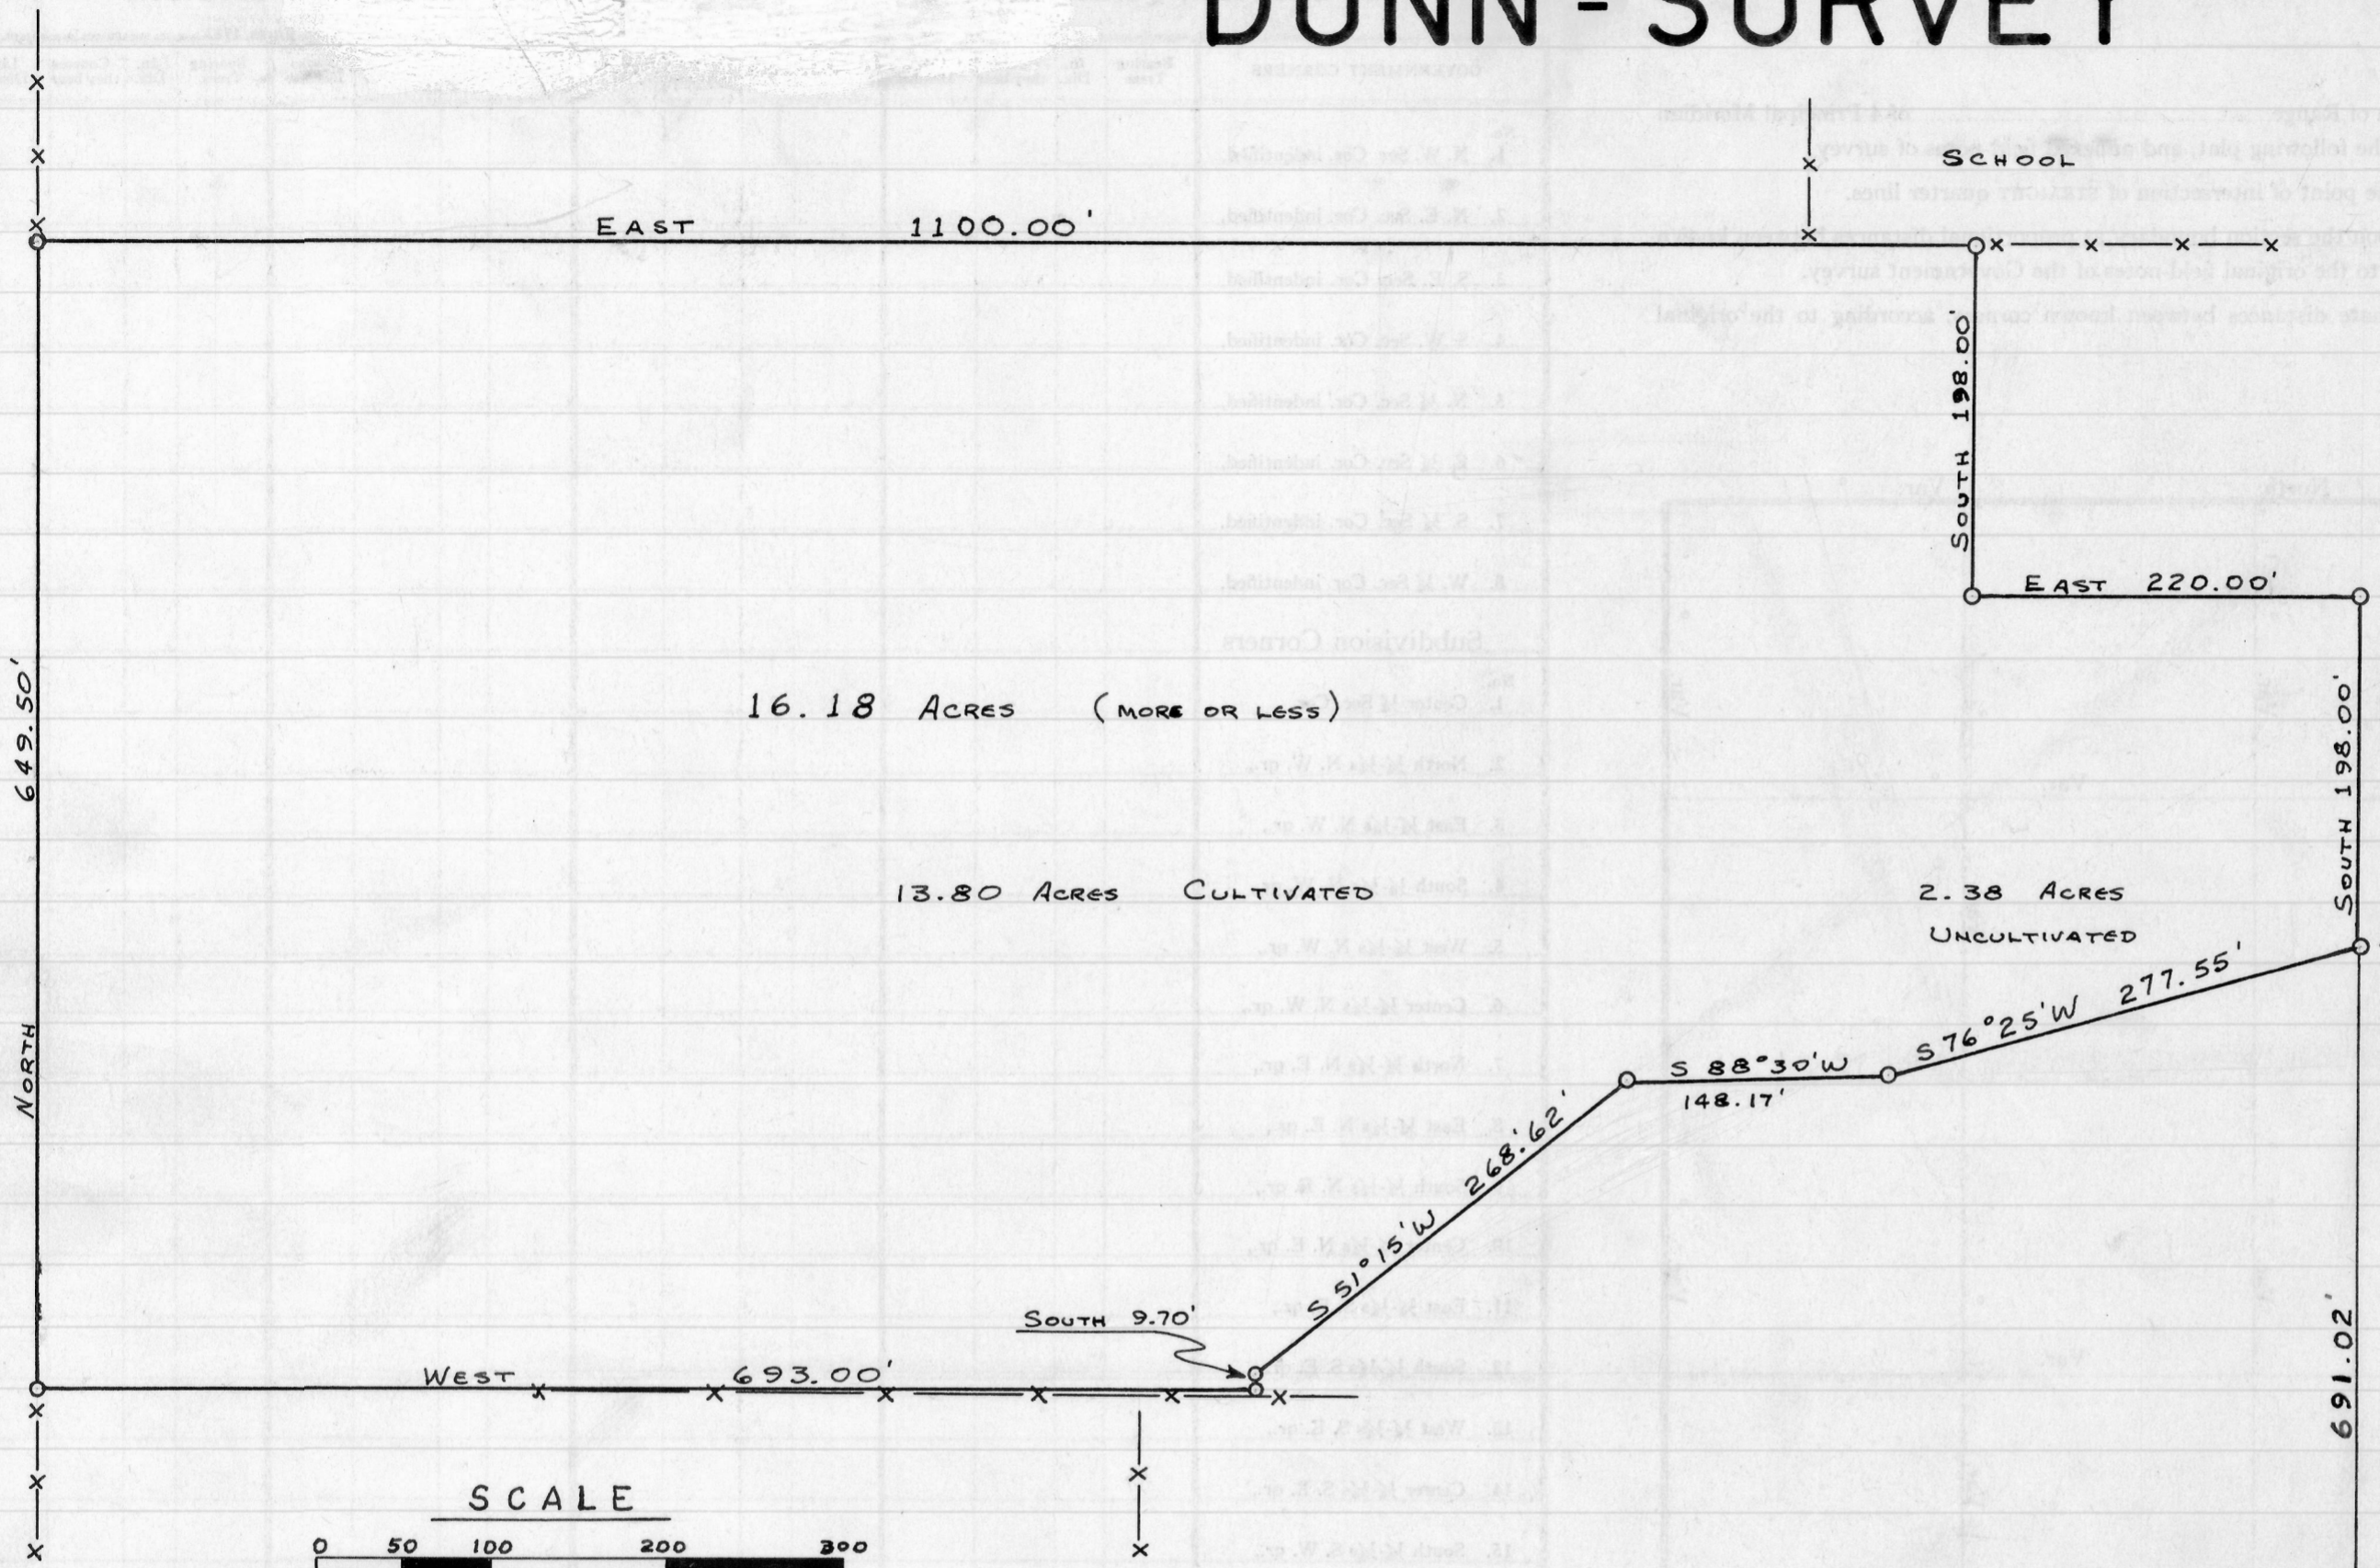

**LEGEND**

- ..... IRON PROPERTY CORNER PIPE, PLACED BY THIS SURVEY.
- SURVEY LINE.
- X—X—X— ..... PRESENT FENCE LINE.

LOCATION DIAGRAM

