
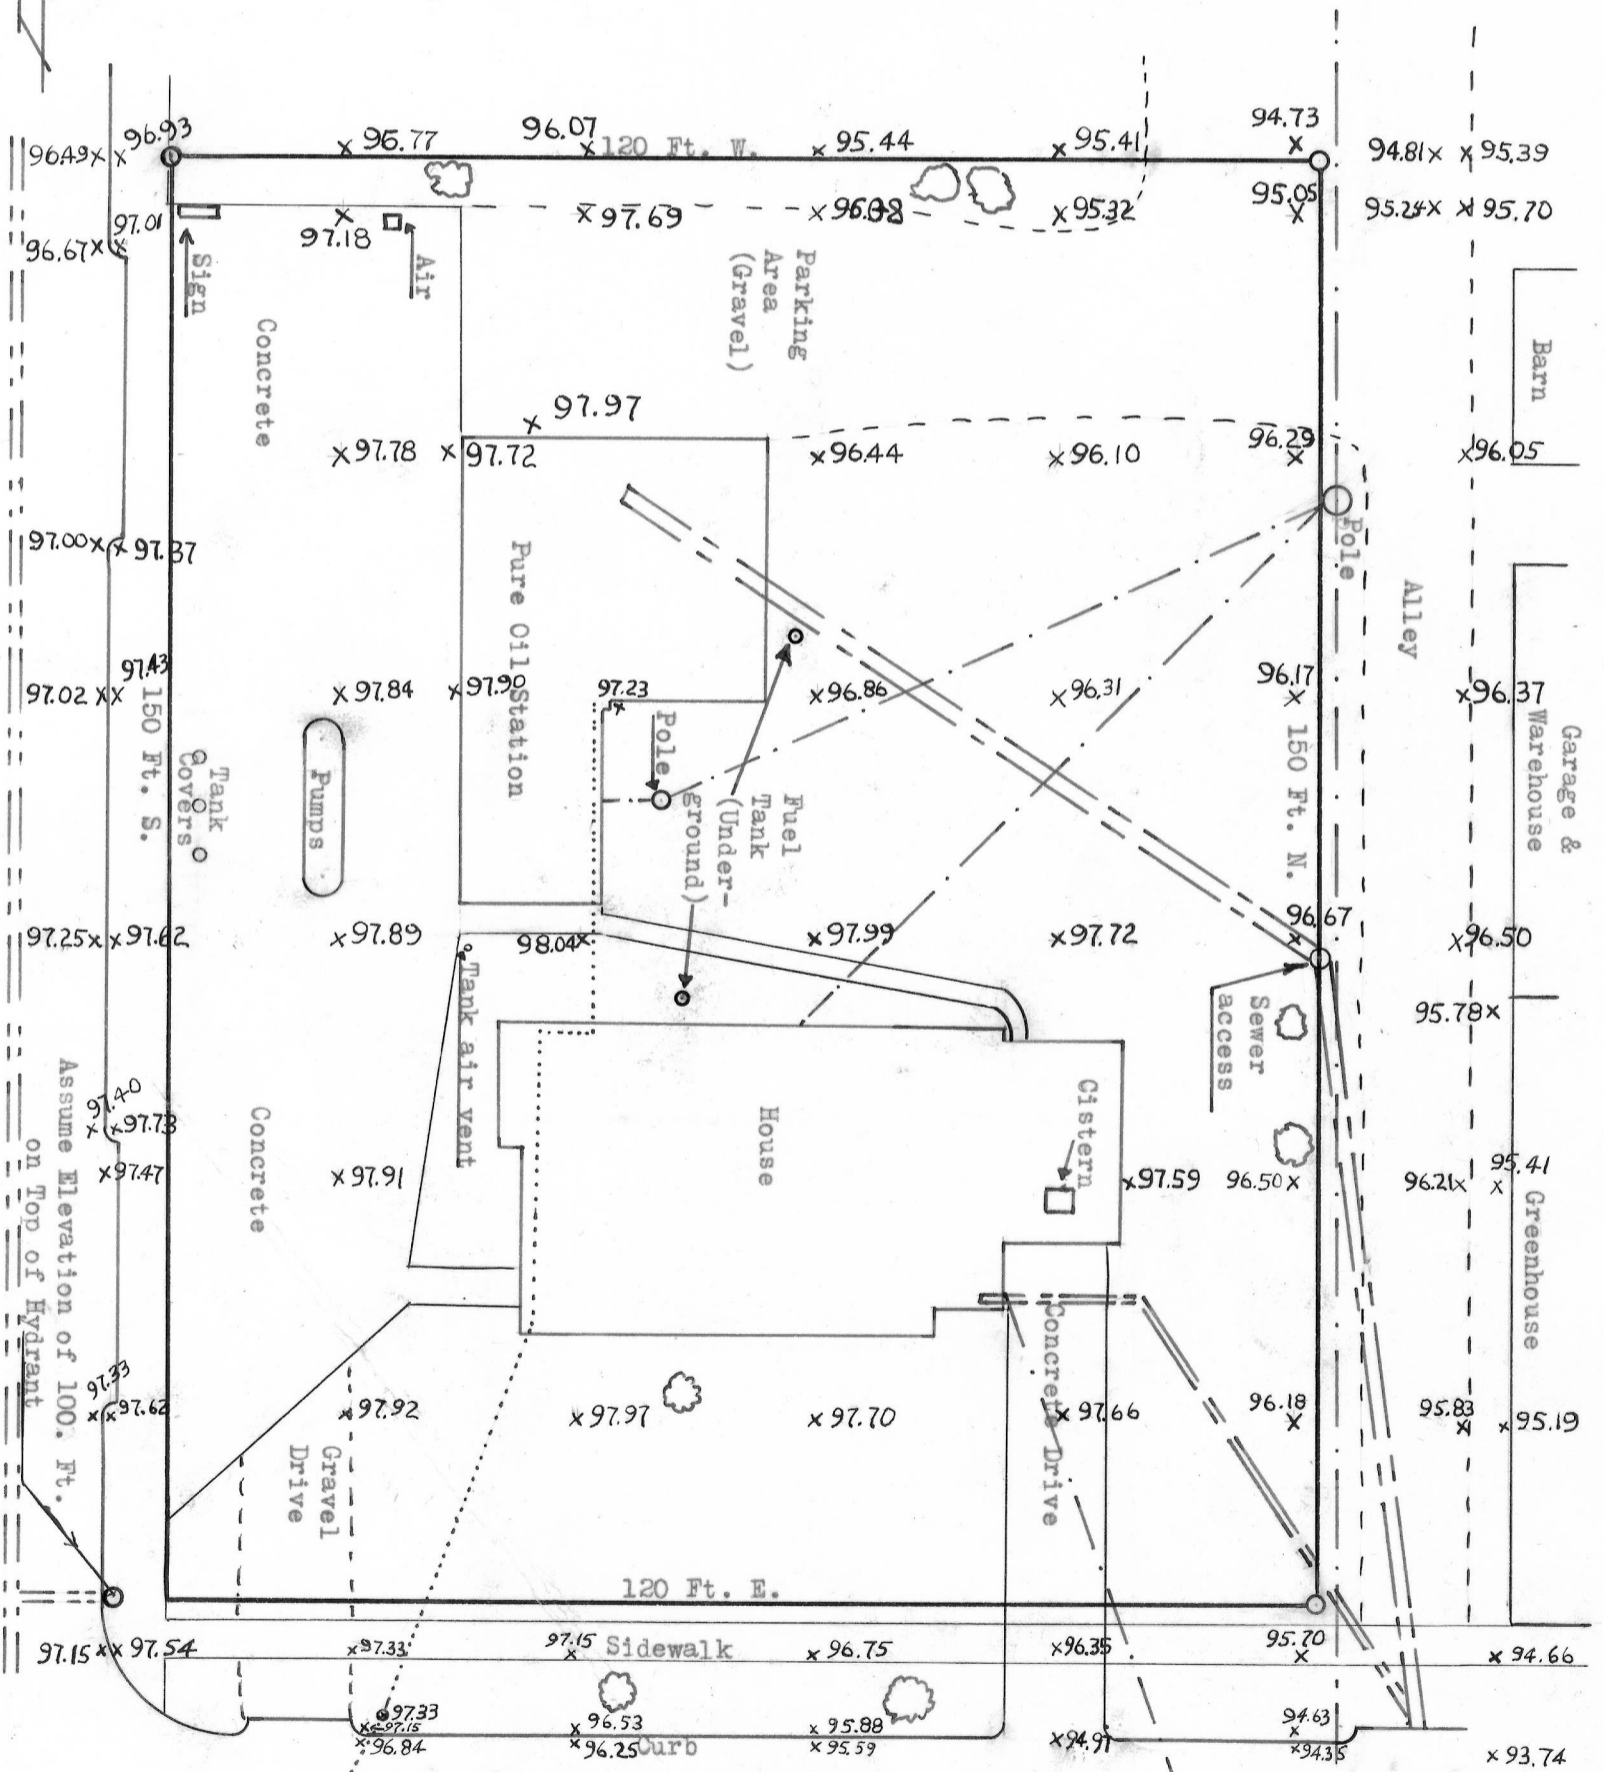


PURE OIL COMPANY - SURVEY

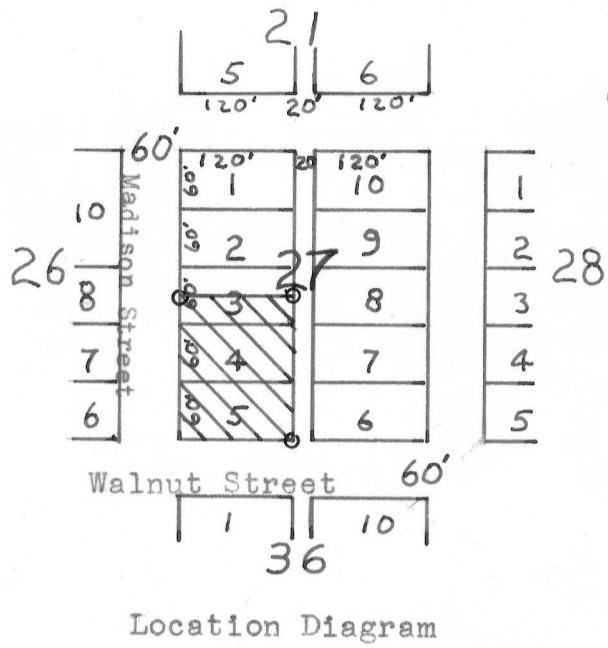

4-3

Pure Oil Company - Survey

Description:

Lots 4 and 5, and the South half of Lot 3 in Block 27 of the Original Plat of the Village (now City) of Lancaster, Grant County, Wisconsin.

Maurice P. Cook
Maurice P. Cook
3/19/66--4/7/66

Homer D. Ralph, Jr.
Homer D. Ralph, Jr.
Surveyor for Grant Co., Wis.
Wis. Reg. No. S-141

