

DESCRIPTION OF LANDS OWNED BY THE BOSCOBEL TELEPHONE COMPANY


The North Forty (40) feet of Lot Nine (9) of Block Eighteen (18) in Brindley's Addition to the Village (now City) of Boscobel, Grant County, Wisconsin, according to the recorded map or plat thereof.

State of Wisconsin )  
County of Grant ) ss

I, Homer D. Ralph, Jr., Surveyor for Grant Co., Wis., hereby certify that on the 27th day of July, A.D., 1957, by order and direction of Mr. Willard Jones, Manager of the Boscobel Telephone Company, I surveyed Block 18 in Brindley's Addition to the Village (now City) of Boscobel, Grant Co., Wis., and that this map and the foregoing description are a true and correct representation of said survey.

*Homer D. Ralph, Jr.*  
Homer D. Ralph, Jr., Surveyor  
for Grant Co., Wis.  
Wis. Reg. No. S-141  
6/27/57 7/12/57

**BLK. 18, BRINDLEY'S  
ADD. - BOSCOBEL**

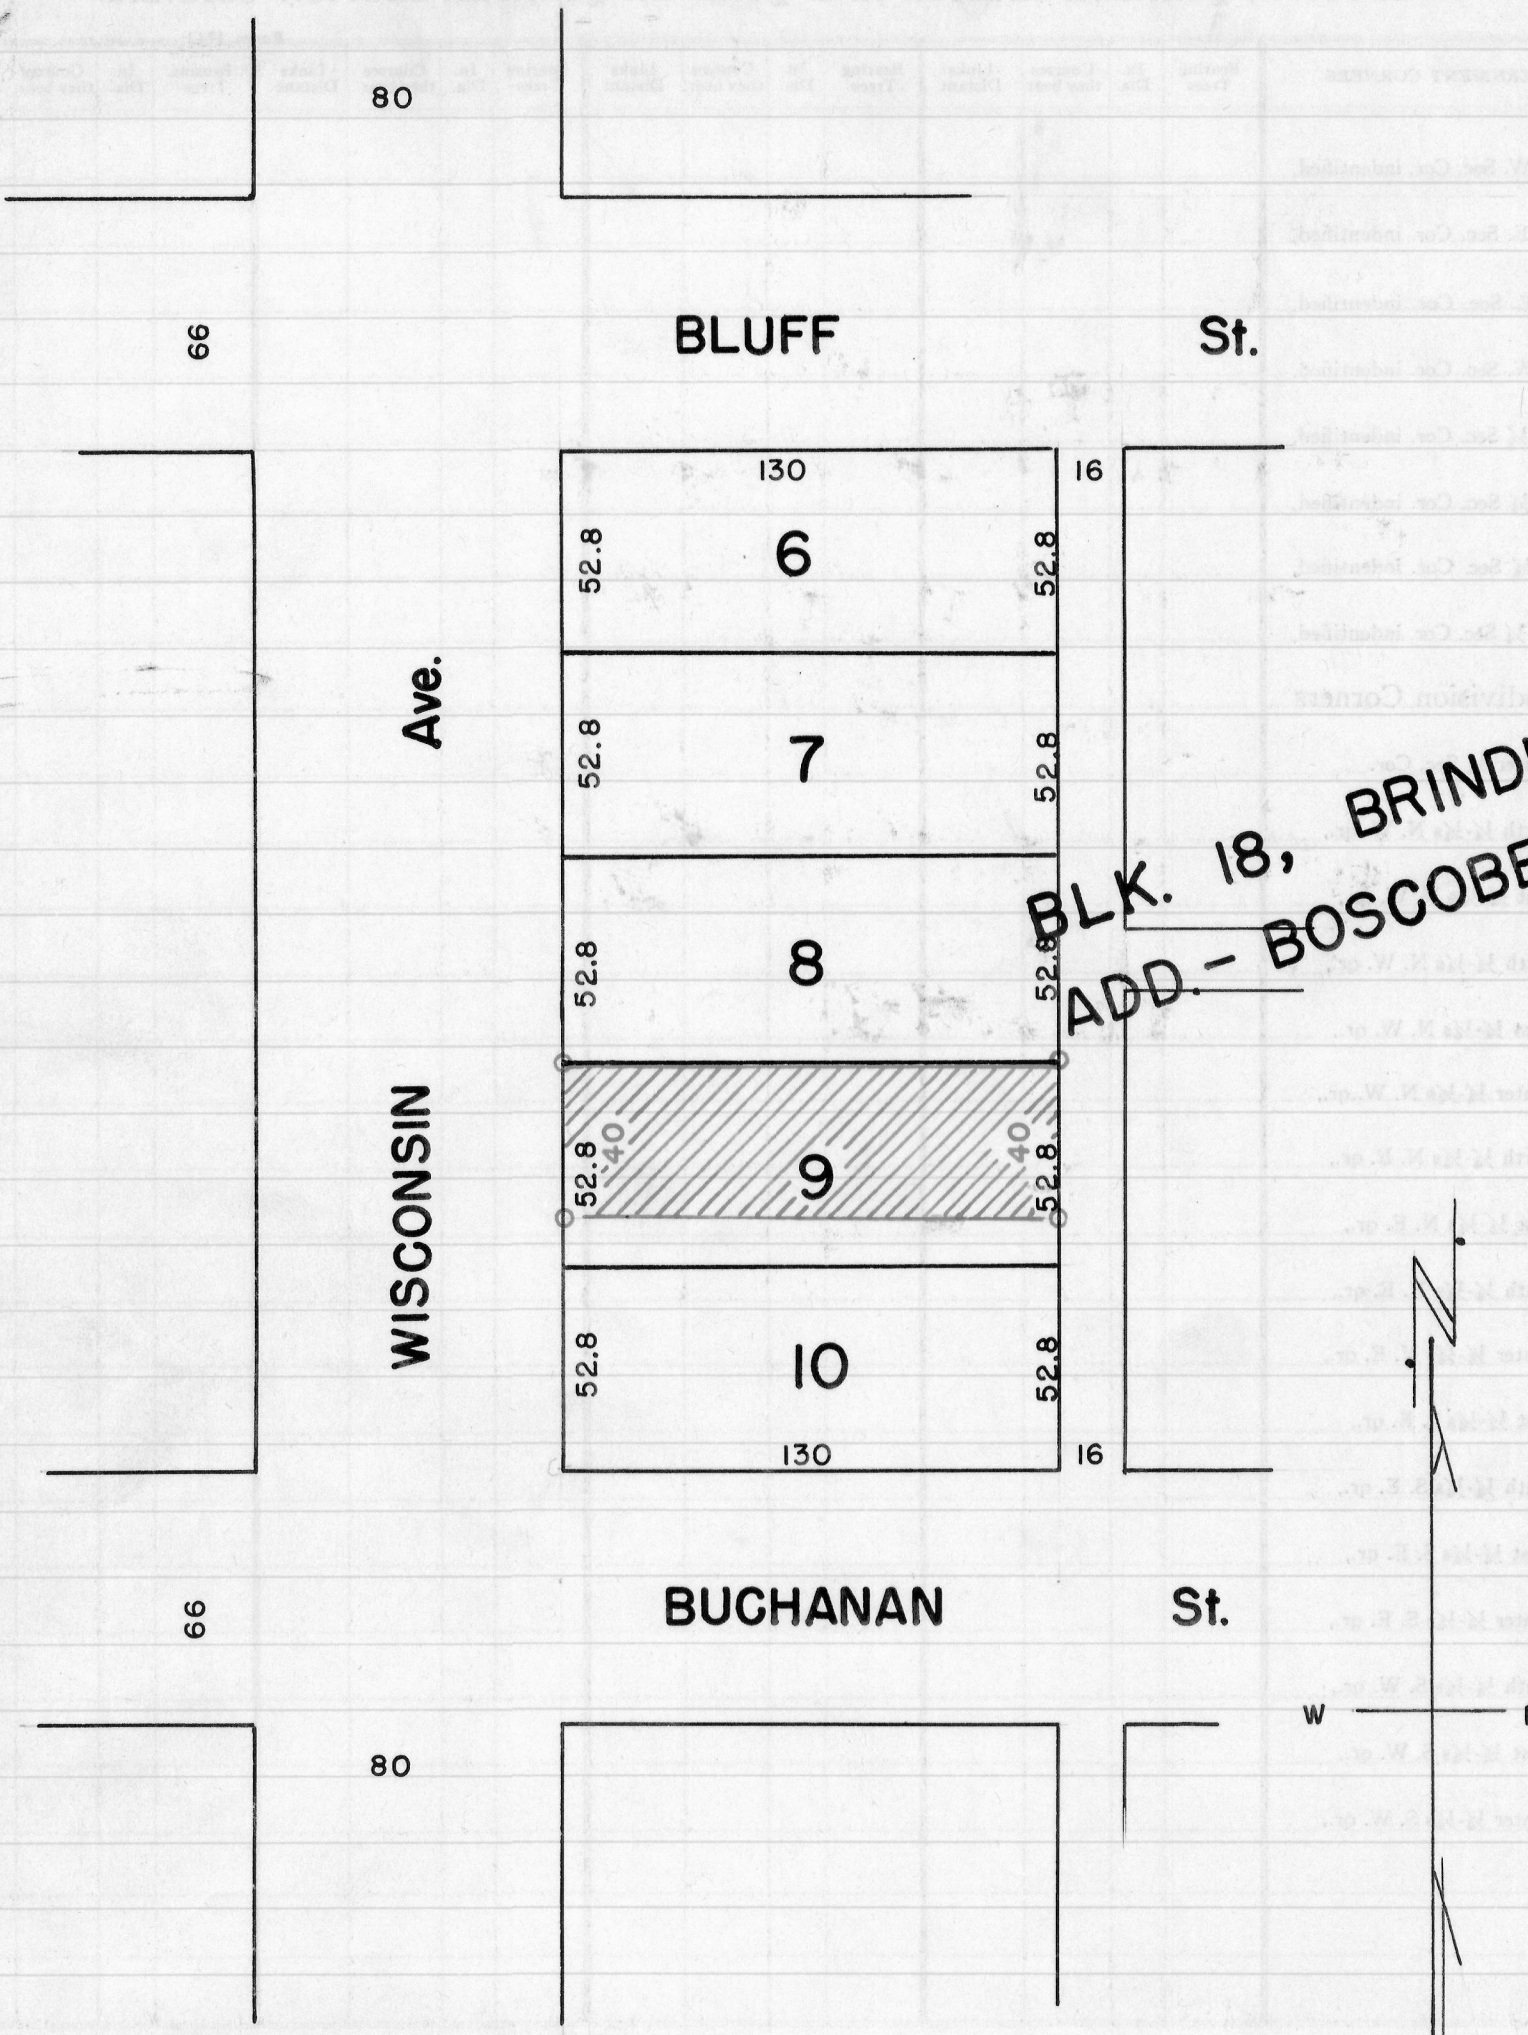

○ - Designates stakes placed by this survey (3/4 inch pipe)

