
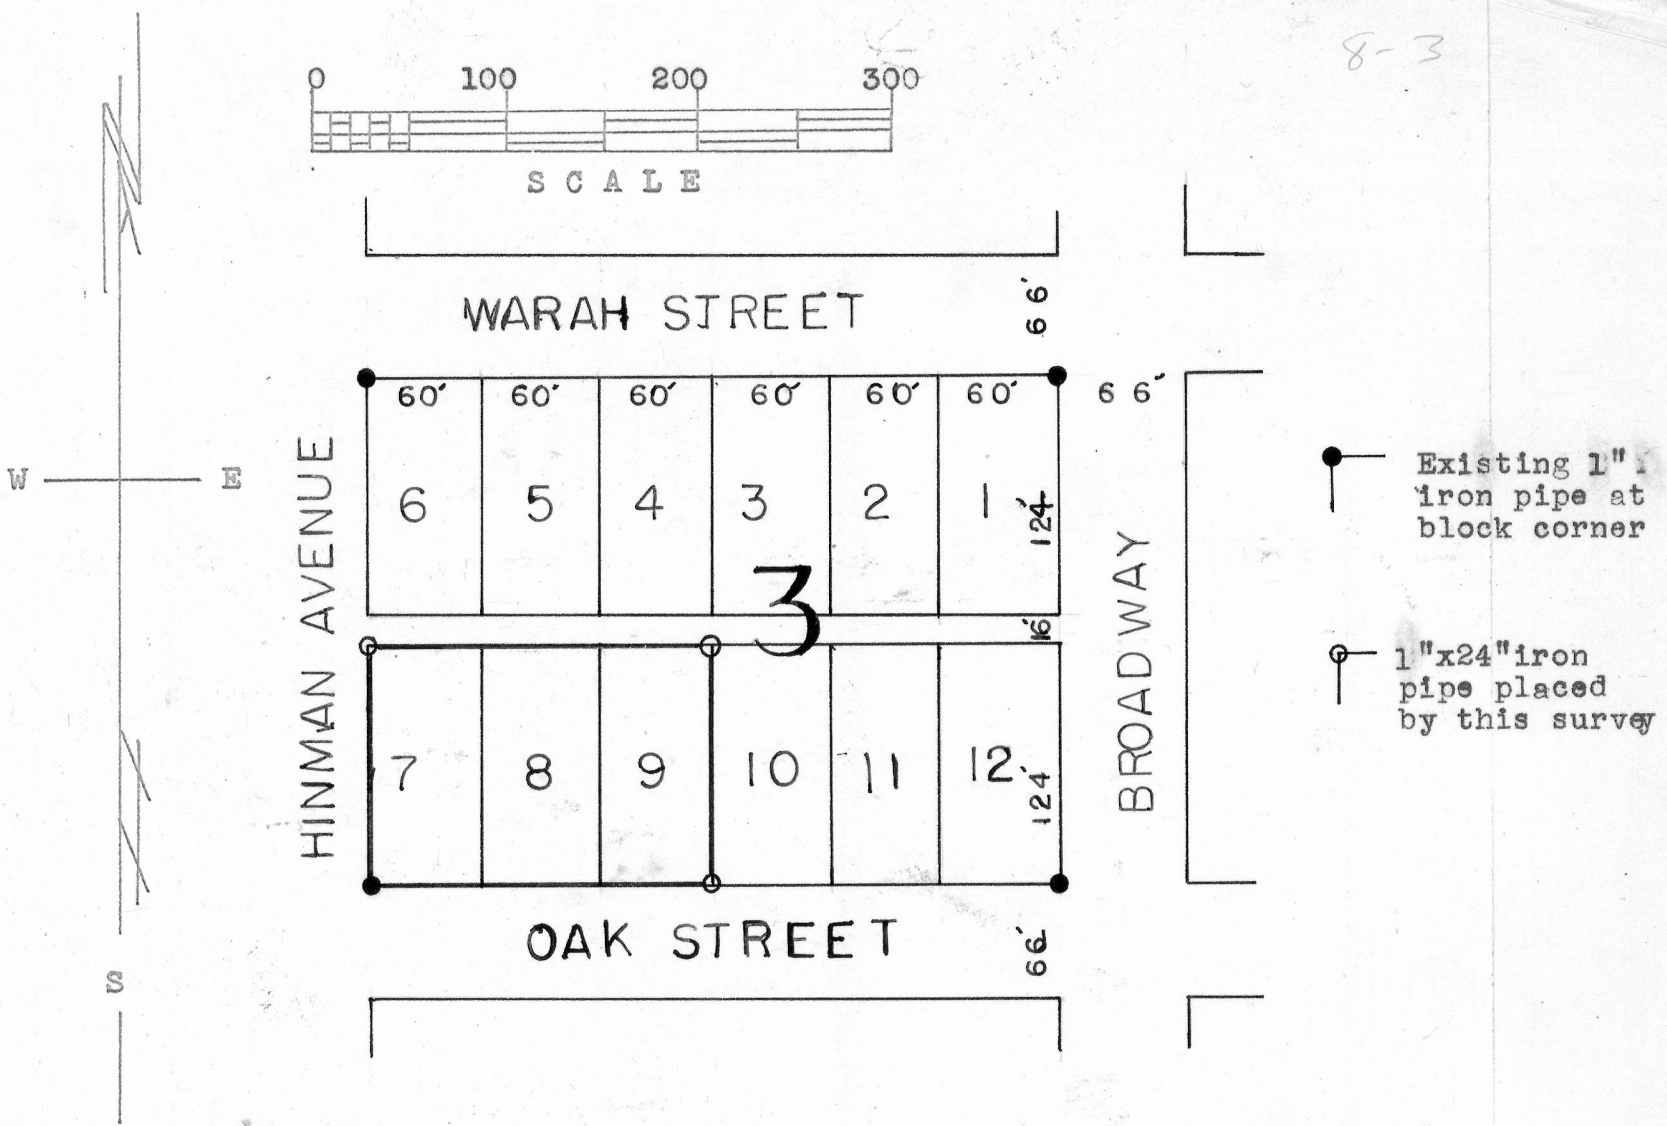


REYNOLDS SURVEY

8-3

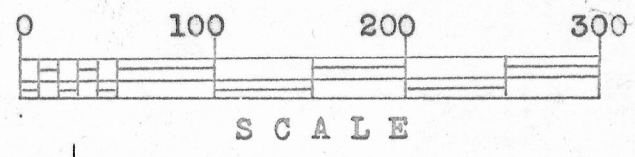

DESCRIPTION:
 Part of Block 3 of Hinman's Addition to the City of Boscobel, Grant County, Wisconsin, According to the recorded map or platt thereof; including all of lots 7, 8, and 9

Daniel L. McNaughton
 Daniel L. McNaughton
 6/28/68

Homer D. Ralph, Jr.
 Homer D. Ralph, Jr.
 Surveyor for Grant Co., Wis.
 Wis. Reg. No. S-141

