

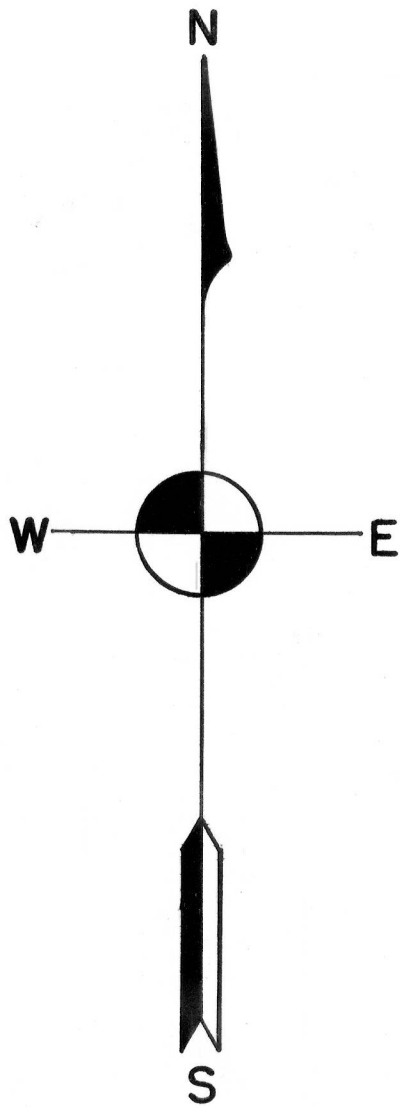


BURNS SURVEY

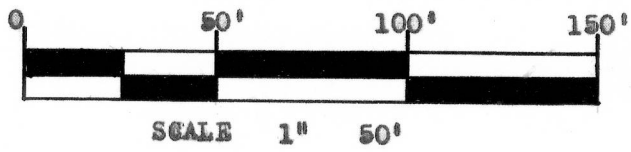

Southern right of way of the
Chicago, Milwaukee, & St. Paul
Railway Company

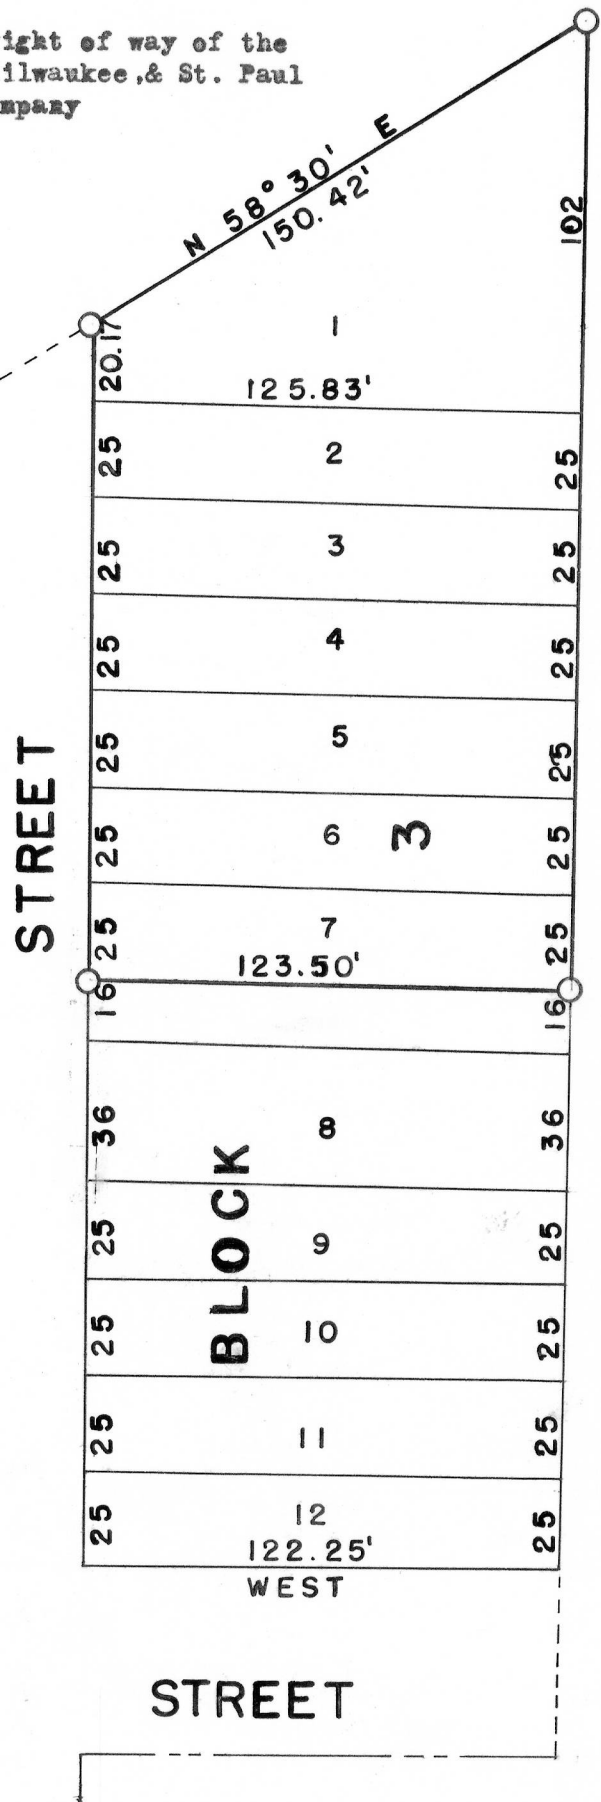

1" x 24" IRON PIPE
PLACED BY THIS
SURVEY

DESCRIPTION:

A part of the N.E. 1/4 of the S.W. 1/4 of Section 26, T 8 N, R 3 W, of the 4th P.M. Grant Co., Wis. described as follows to-wit; Lots 1,2,3,4,5,6,&7 of block 3 of Clark's Addition to the City of Escobal, Grant Co., Wis.

Daniel L. McNaughton
Daniel L. McNaughton
8/23/68-8/29/68

Homer D. Ralph, Jr.
Homer D. Ralph, Jr.
Surveyor For Grant Co., Wis.
Wis. Reg. No. S-141