



-READY SURVEY

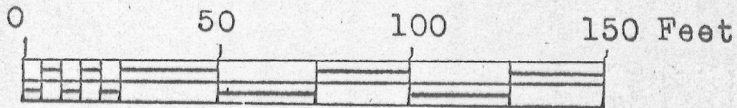

SCALE

1" x 24" iron pipe placed by this survey.

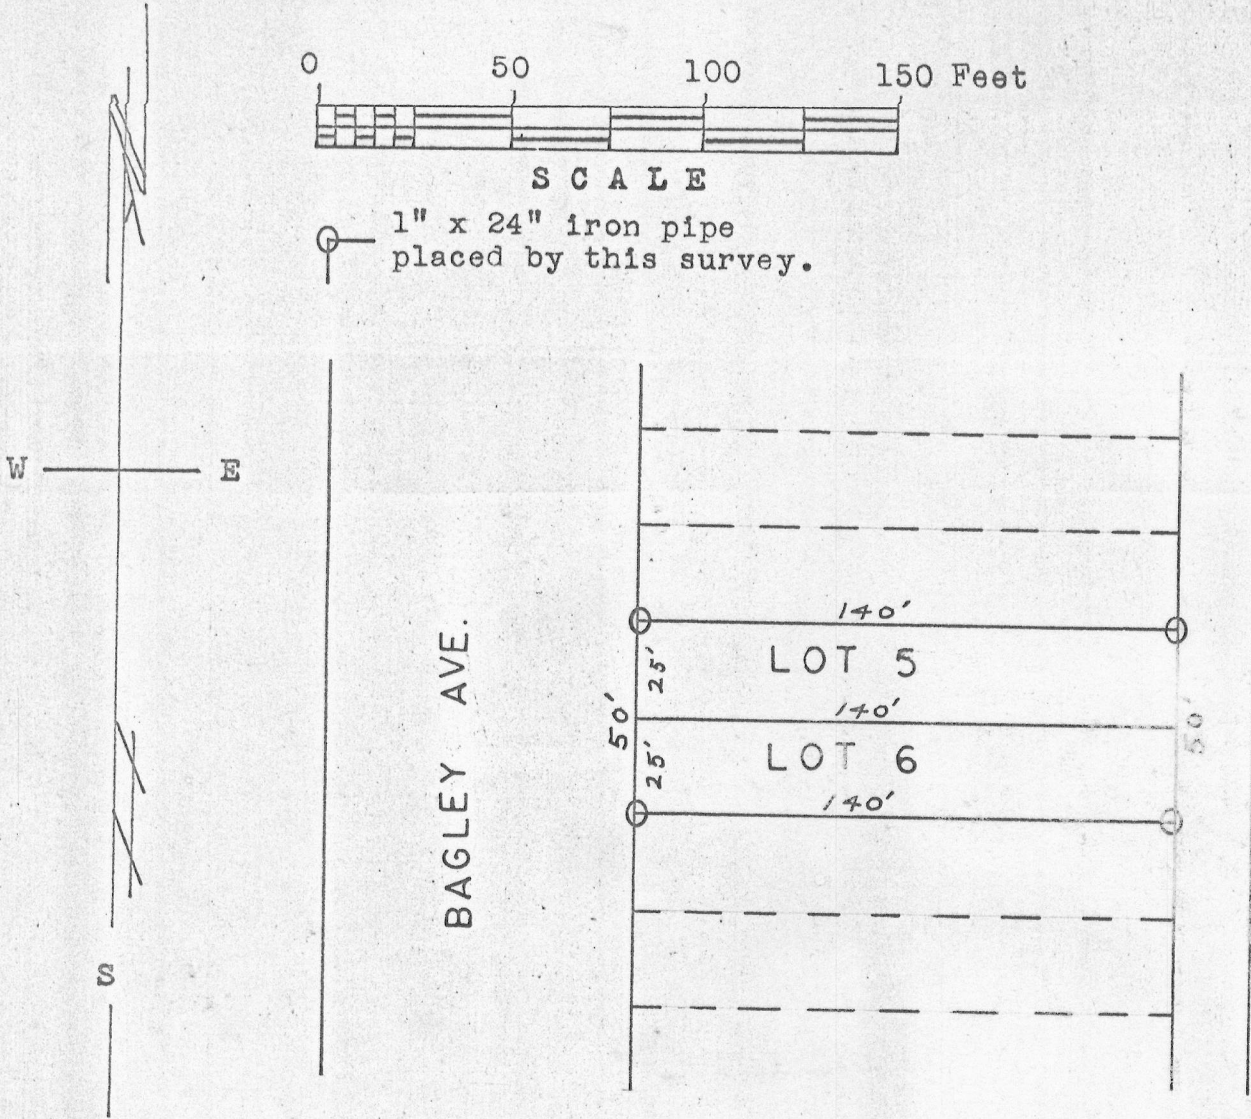

Description:

Lots Five (5) and Six (6) in Block Six (6) of the Village of Bagley, Grant County, Wisconsin, according to the recorded map or plat thereof.

Thomas S. Bainbridge
 Thomas S. Bainbridge
 5/19/67-6/2/67

Homer D. Ralph, Jr.
 Homer D. Ralph, Jr.
 Surveyor for Grant Co., Wis.
 Wis. Reg. No. S-141

