




# STELLA CHEESE CO. SURVEY

March 24, 1961

○ Designates stakes placed by this survey  
Iron pipe 1" by 2"

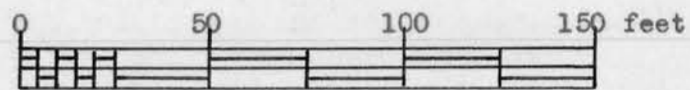

scale

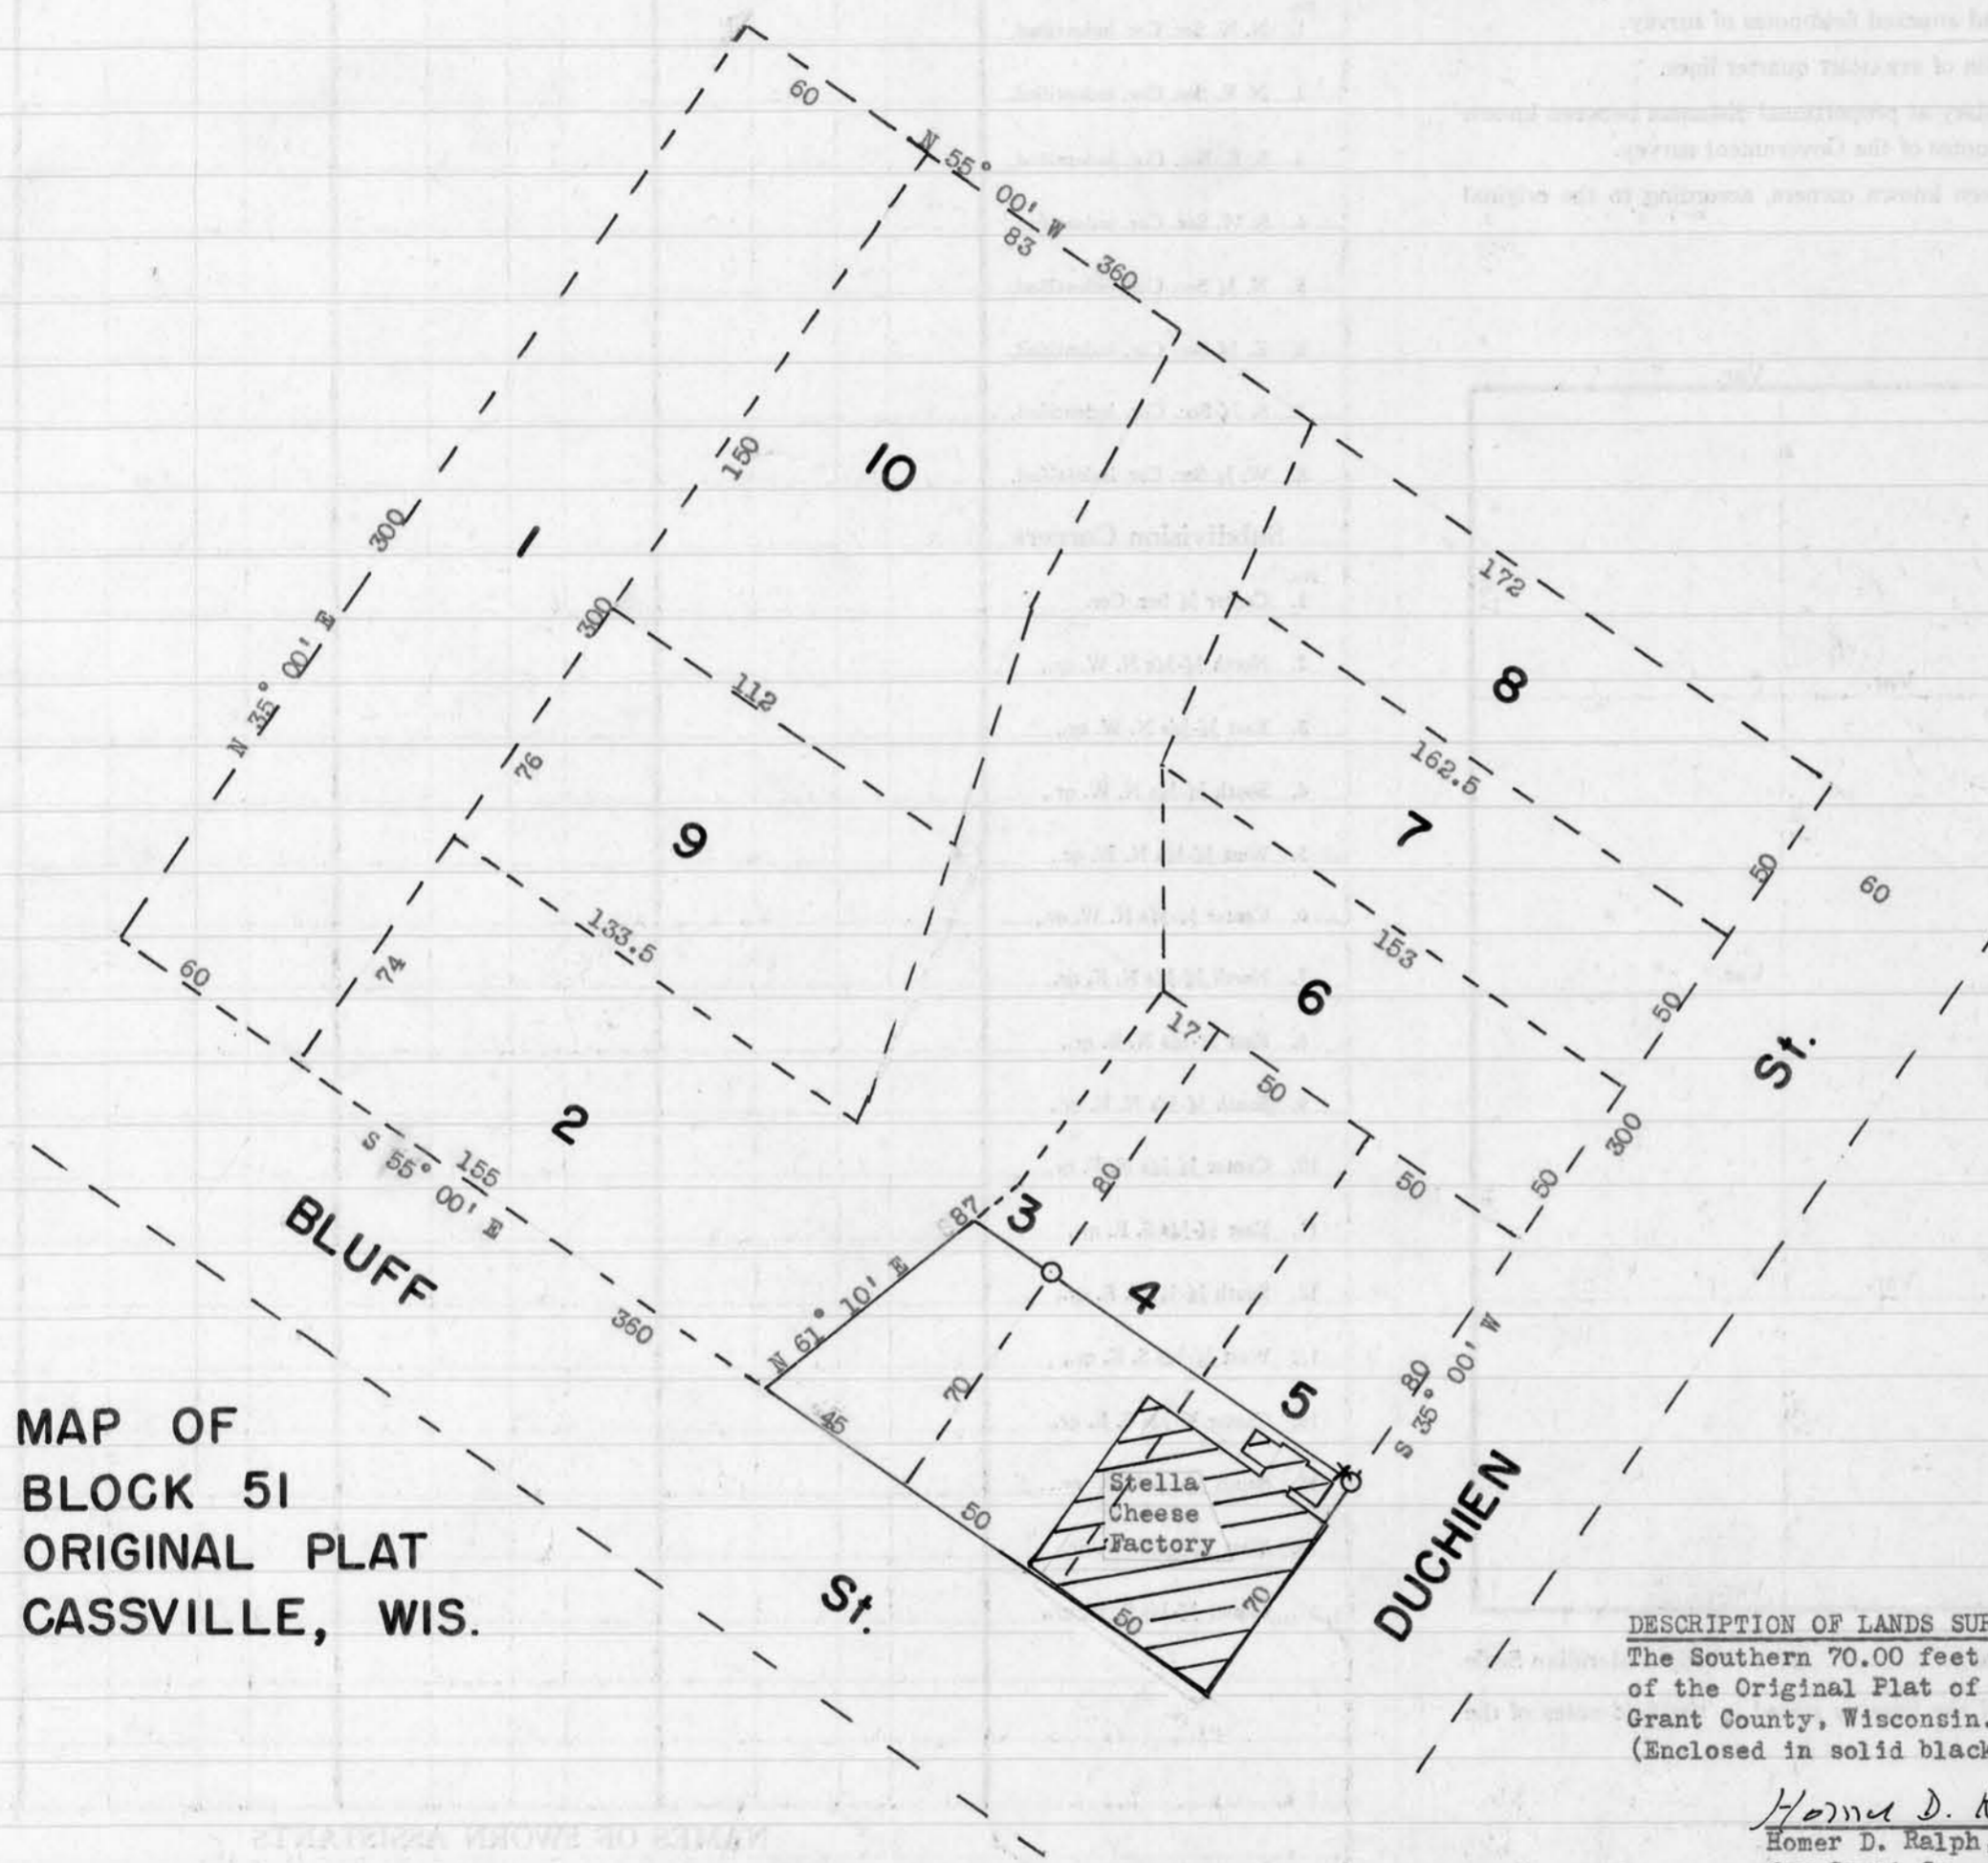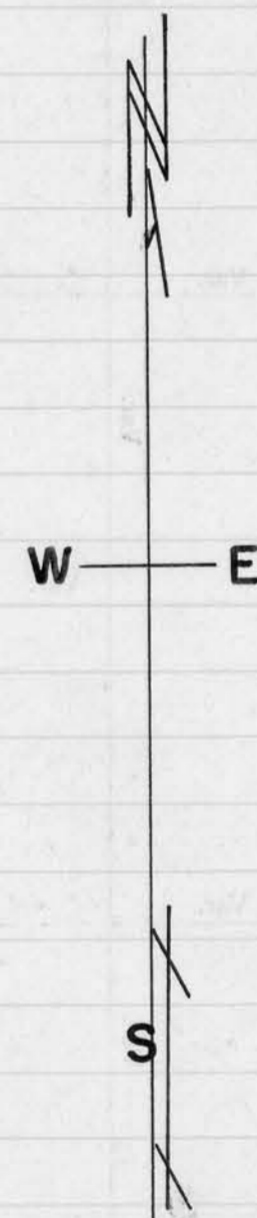

MAP OF  
BLOCK 51  
ORIGINAL PLAT  
CASSVILLE, WIS.

**DESCRIPTION OF LANDS SURVEYED**  
The Southern 70.00 feet of Lots 3, 4 and 5, Block 51,  
of the Original Plat of the Village of Cassville,  
Grant County, Wisconsin.  
(Enclosed in solid black lines on map)

*Homer D. Ralph, Jr.*  
Homer D. Ralph, Jr. Surveyor  
for Grant Co., Wis.  
Wis. Reg. No. S-141  
4/4/61