

Record of Survey.

DESCRIPTION

248
OVER

OF SECTION, QUARTER SECTION AND QUARTER QUARTER SECTION CORNERS

Form 1742 H. C. MILLER CO., MILWAUKEE

Township 5, North of Range 5 W of 4 Principal Meridian as presented by the courses and distances on the following plat, and annexed field-notes of survey:

Established the center of the section at the point of intersection of STRAIGHT quarter lines.

Established all quarter-quarter corners upon the section boundary at proportional distances between known section and quarter section corners, according to the original field-notes of the Government survey.

Established all lost corners at proportionate distances between known corners, according to the original field notes of the Government survey.



Plat of Section 4, Township 5 North, Range 5 W of 4 Principal Meridian Scale 80 chains to 6 inches. The figures in red ink are the lengths of the lines as stated in the field-notes of the Government survey.

Declination of the Magnetic Meridian from the True Meridian.....

Surveyed and sub-divided..... A. D. 1, in accordance with the State Laws and Instructions of the Commissioner of the General Land office, and recorded on pages..... of Register in the County Clerk's office.

Witness my hand this 21st day of April 1902 A. D. 1

H. D. Ralph SURVEYOR.

see other side


No.	GOVERNMENT CORNERS				Subdivision Corners				GOVERNMENT CORNERS				Subdivision Corners			
	Bearing Trees	In. Dia.	Courses they bear	Links Distant	Bearing Trees	In. Dia.	Courses they bear	Links Distant	Bearing Trees	In. Dia.	Courses they bear	Links Distant	Bearing Trees	In. Dia.	Courses they bear	Links Distant
1.																
2.																
3.																
4.																
5.																
6.																
7.																
8.																
Subdivision Corners																
1.																
2.																
3.																
NAMES OF SWORN ASSISTANTS

CHAINMEN	FLAGMEN	AXMEN
<u>Wm. A. Graf</u>		

Iron pin in sidewalk

1/4 Post on N. side of Sec. 4, T 5 N R 5 W.

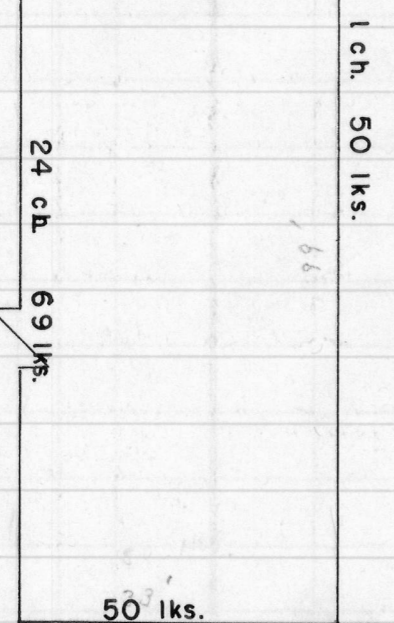


1 ch. 50 lks.

50 lks.

1 ch. 50 lks.

Art Neises 266-295

45.5 lks.

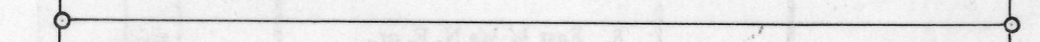

1 ch. 79.5 lks.
2 ch. 25 lks.

Wm. A. Graf 300-55

2 ch. 25 lks.
1 ch. 79.5 lks.

1 ch. 50 lks.

