

DESCRIPTION

Record of Survey.

OF SECTION, QUARTER SECTION AND QUARTER QUARTER SECTION CORNERS


Form 1742 H. C. MILLER CO., MILWAUKEE

Township 4, North of Range 3 West of 4 Principal Meridian as presented by the courses and distances on the following plat, and annexed field-notes of survey:

Established the center of the section at the point of intersection of STRAIGHT quarter lines.

Established all quarter-quarter corners upon the section boundary at proportional distances between known section and quarter section corners, according to the original field-notes of the Government survey.

Established all lost corners at proportionate distances between known corners, according to the original field notes of the Government survey.

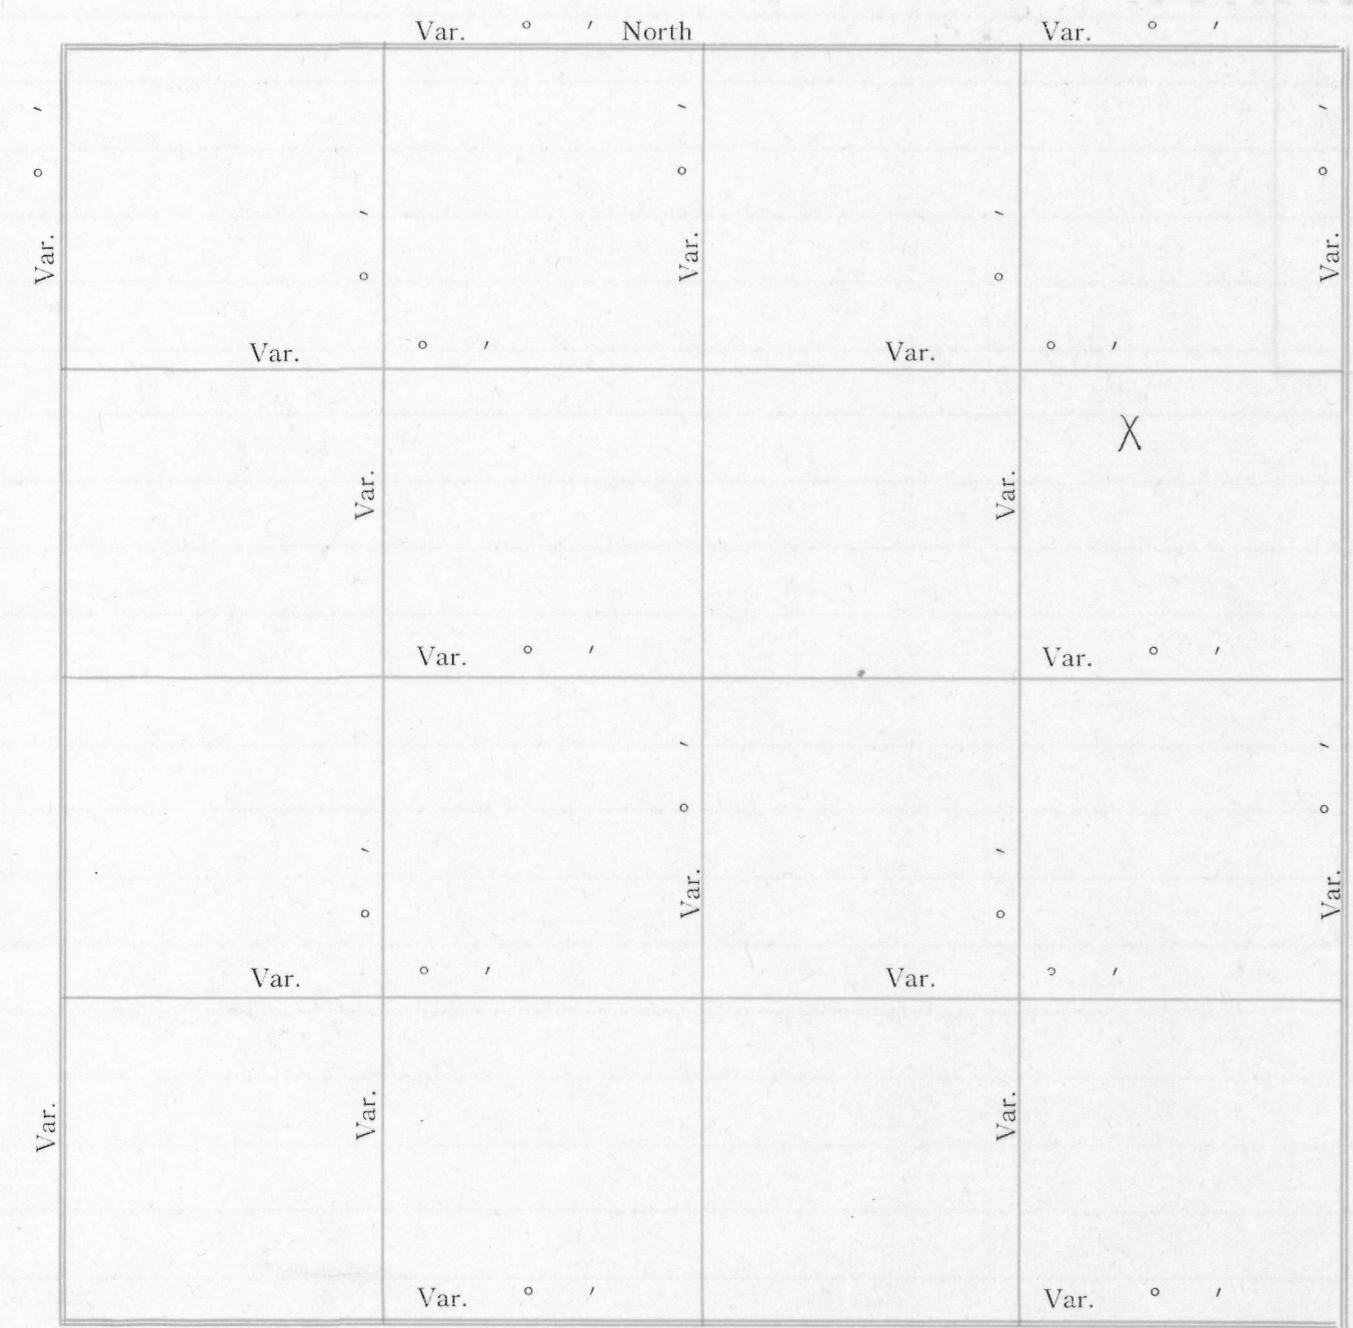

Plat of Section 10, Township 4 North, Range 3 West of 4 Principal Meridian Scale 80 chains to 6 inches. The figures in red ink are the lengths of the lines as stated in the field-notes of the Government survey.

Declination of the Magnetic Meridian from the True Meridian.....

Surveyed and sub-divided Nov. 19 A. D. 1952, in accordance with the State Laws and Instructions of the Commissioner of the General Land office, and recorded on pages of Register in the County Clerk's office.

Witness my hand this 27th day of Dec A. D. 1952


H. D. Ralph SURVEYOR.
in the city of Lancaster 51st St Co. Wis.

No.	GOVERNMENT CORNERS															
	Bearing Trees	In. Dia.	Courses they bear	Links Distant	Bearing Trees	In. Dia.	Courses they bear	Links Distant	Bearing Trees	In. Dia.	Courses they bear	Links Distant	Bearing Trees	In. Dia.	Courses they bear	Links Distant
1.	N. W. Sec. Cor. identified,															
2.	N. E. Sec. Cor. identified,															
3.	S. E. Sec. Cor. identified,															
4.	S. W. Sec. Cor. identified,															
5.	N. 1/4 Sec. Cor. identified,															
6.	E. 1/4 Sec. Cor. identified,															
7.	S. 1/4 Sec. Cor. identified,															
8.	W. 1/4 Sec. Cor. identified,															
Subdivision Corners																
1.	Center 1/4 Sec. Cor.															
2.	North 1/4-1/4s N. W. qr.,															
3.	East 1/4-1/4s N. W. qr.,															
4.	South 1/4-1/4s N. W. qr.,															
5.	West 1/4-1/4s N. W. qr.,															
6.	Center 1/4-1/4s N. W. qr.,															
7.	North 1/4-1/4s N. E. qr.,															
8.	East 1/4-1/4s N. E. qr.,															
9.	South 1/4-1/4s N. E. qr.,															
10.	Center 1/4-1/4s N. E. qr.,															
11.	East 1/4-1/4s S. E. qr.,															
12.	South 1/4-1/4s S. E. qr.,															
13.	West 1/4-1/4s S. E. qr.,															
14.	Center 1/4-1/4s S. E. qr.,															
15.	South 1/4-1/4s S. W. qr.,															
16.	West 1/4-1/4s S. W. qr.,															
17.	Center 1/4-1/4s S. W. qr.,															

NAMES OF SWORN ASSISTANTS

CHAINMEN	FLAGMEN	AXMEN
<u>E. Alex Bailey</u>		

BLUM-SURVEY

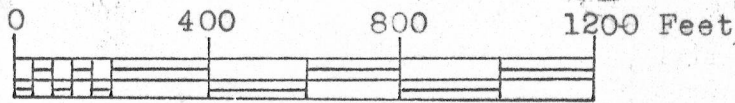

SCALE 1"=400'

- Rock 4"x8" previously placed corner of Sections 26,27,34,35, T4N, R6W, 4th P.M., Grant Co., Wis.
- 1"x24", 1.13 Lbs/Lin. Ft. iron pipe placed by this survey.

W ————— E

S

27	26
34	35

South 2640'

John Rauch

John Rauch

West 1320.00'
Existing Fence line.

Kaufman

Lawrence Blum

N.W.1/4 of S.E.1/4
of Sec. 34, T 4 N,
R 6 W. of the 4th
P.M., Grant Co.,
Wis.

South 1320.00'

Thomas S. Bainbridge
Thomas S. Bainbridge
4/18/68-5/25/68

Homer D. Ralph, Jr.
Homer D. Ralph, Jr.
Surveyor for Grant Co., Wis.
Wis. Reg. No. S-141