


1" = 40'

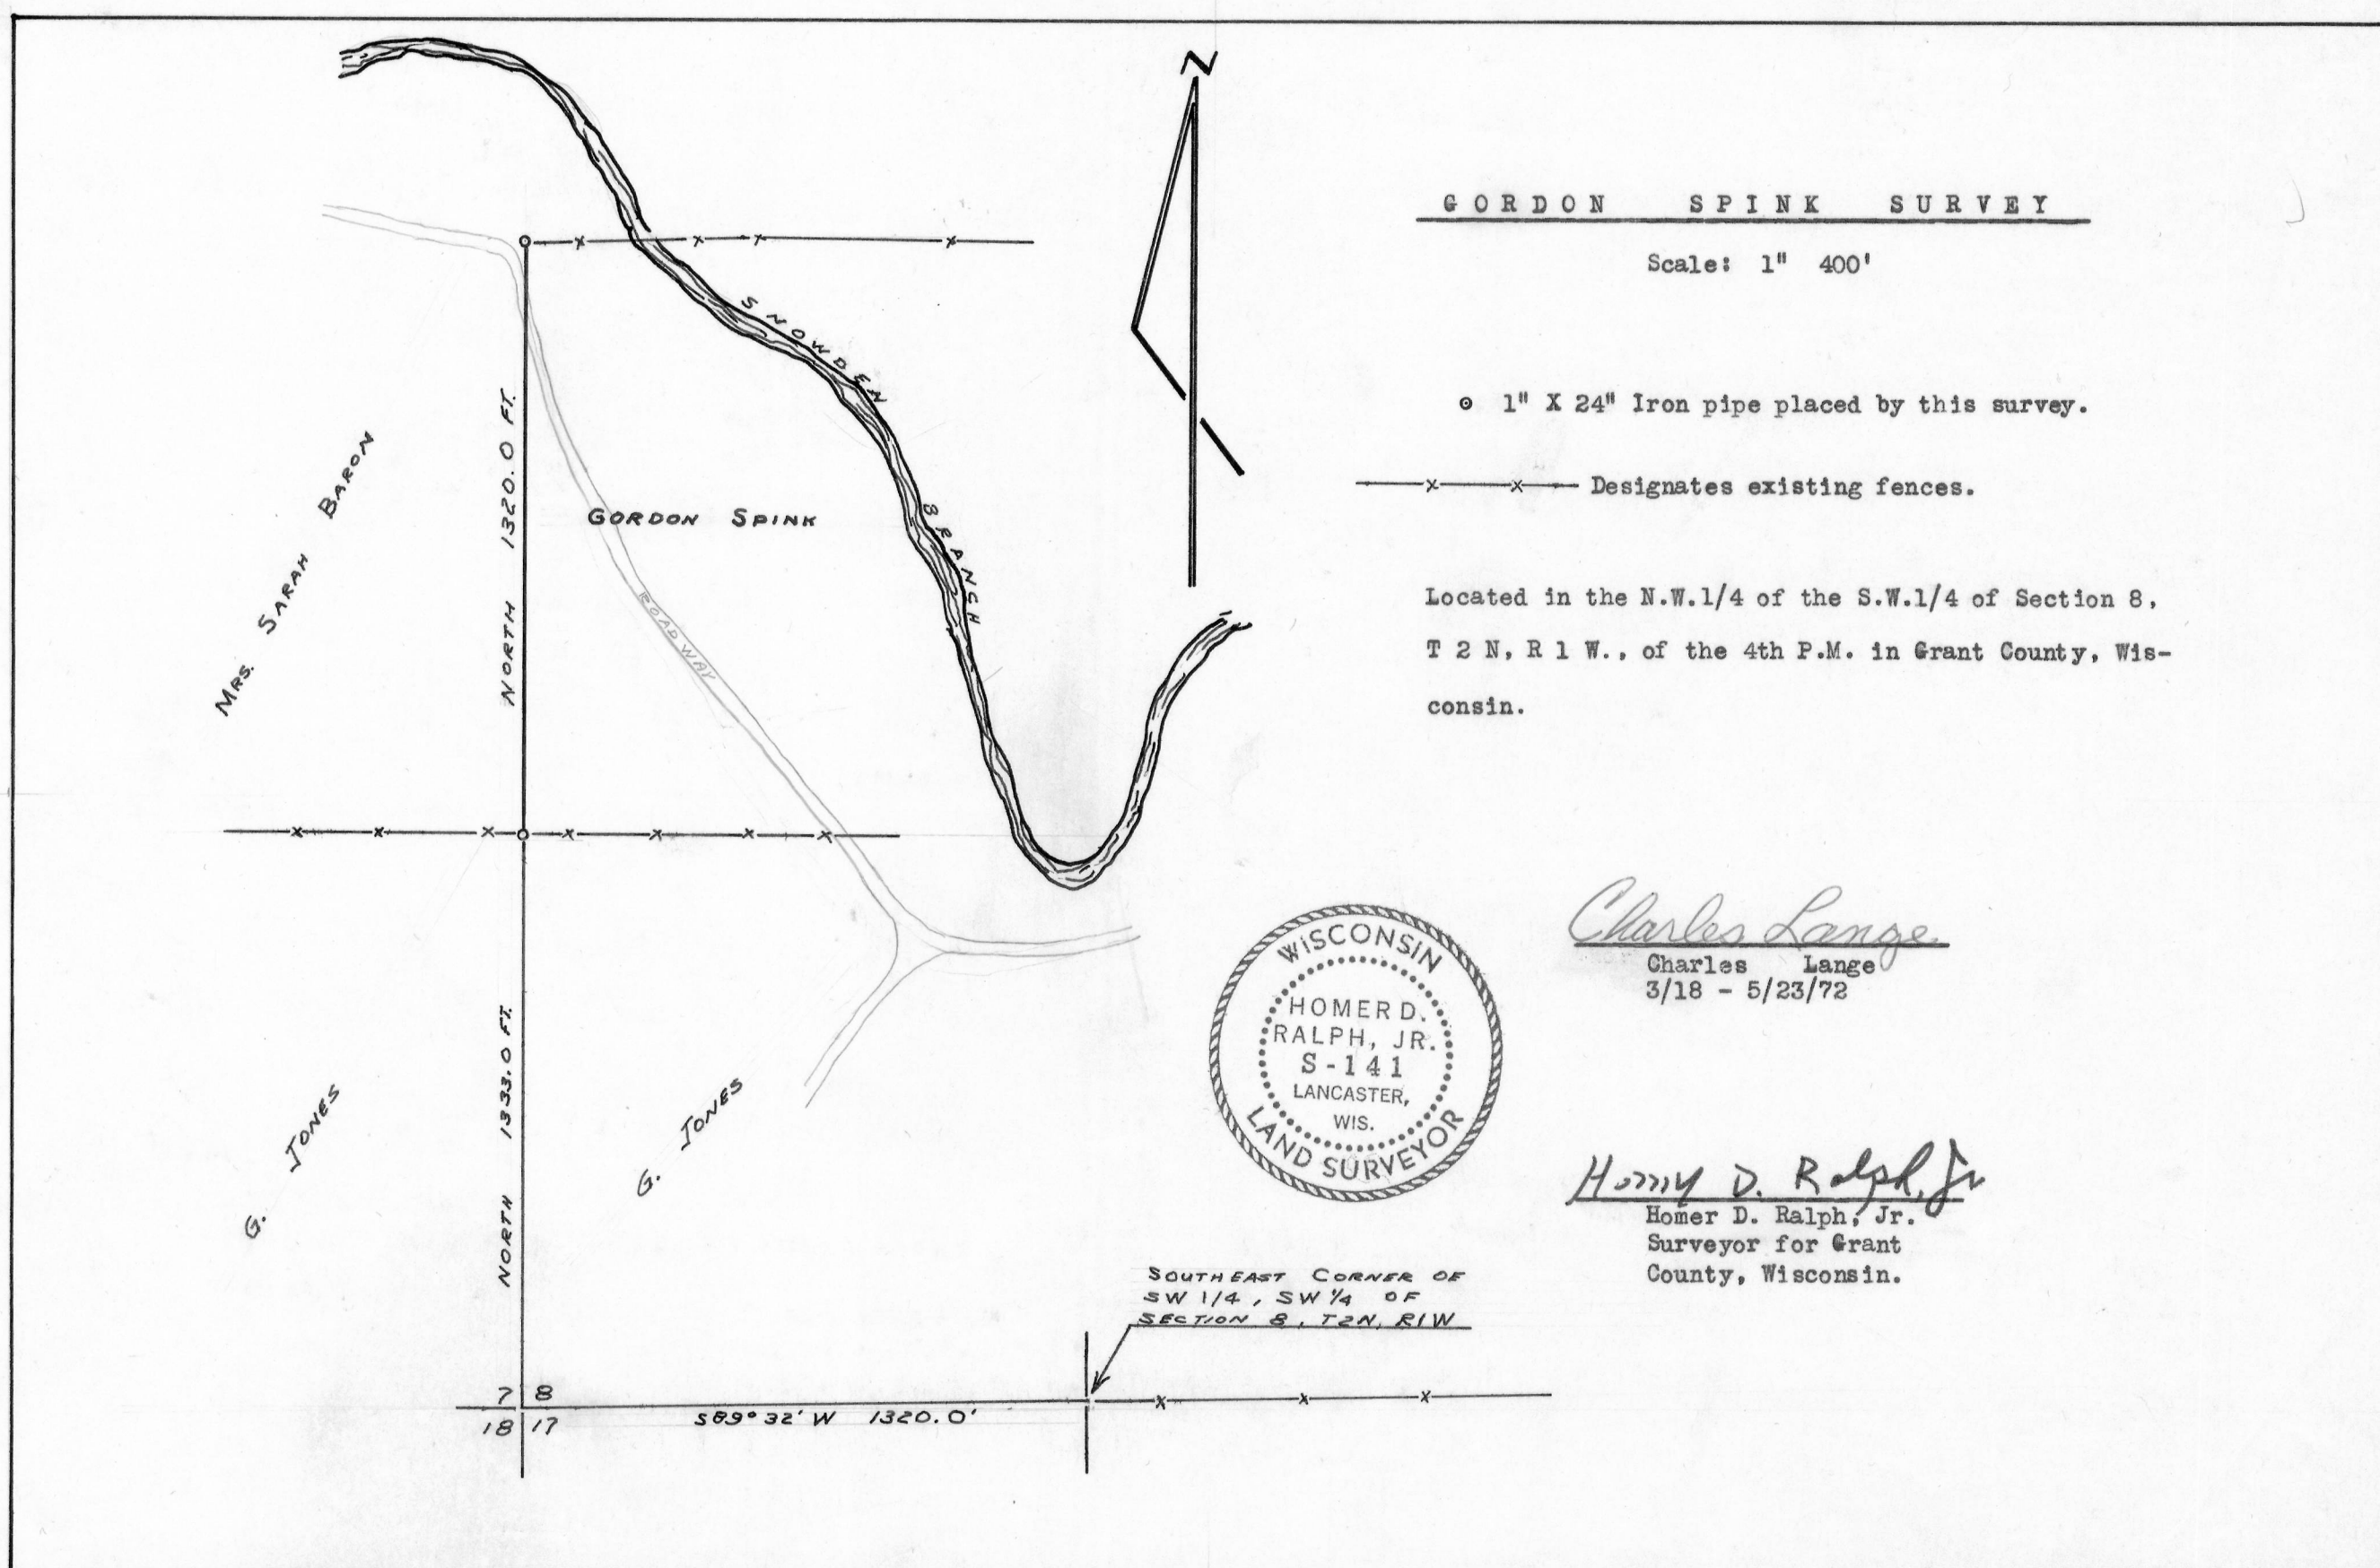


GORDON SPINK SURVEY

Scale: 1" 400'

o 1" X 24" Iron pipe placed by this survey.

— x — x — Designates existing fences.

Located in the N.W.1/4 of the S.W.1/4 of Section 8,
T 2 N, R 1 W., of the 4th P.M. in Grant County, Wis-
consin.

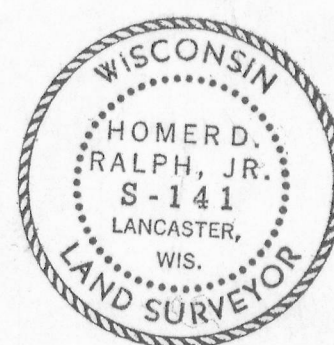

Charles Lange
Charles Lange
3/18 - 5/23/72

Homer D. Ralph, Jr.
Homer D. Ralph, Jr.
Surveyor for Grant
County, Wisconsin.

SOUTHEAST CORNER OF
SW 1/4, SW 1/4 OF
SECTION 8, T2N, R1W