



JONES SURVEY

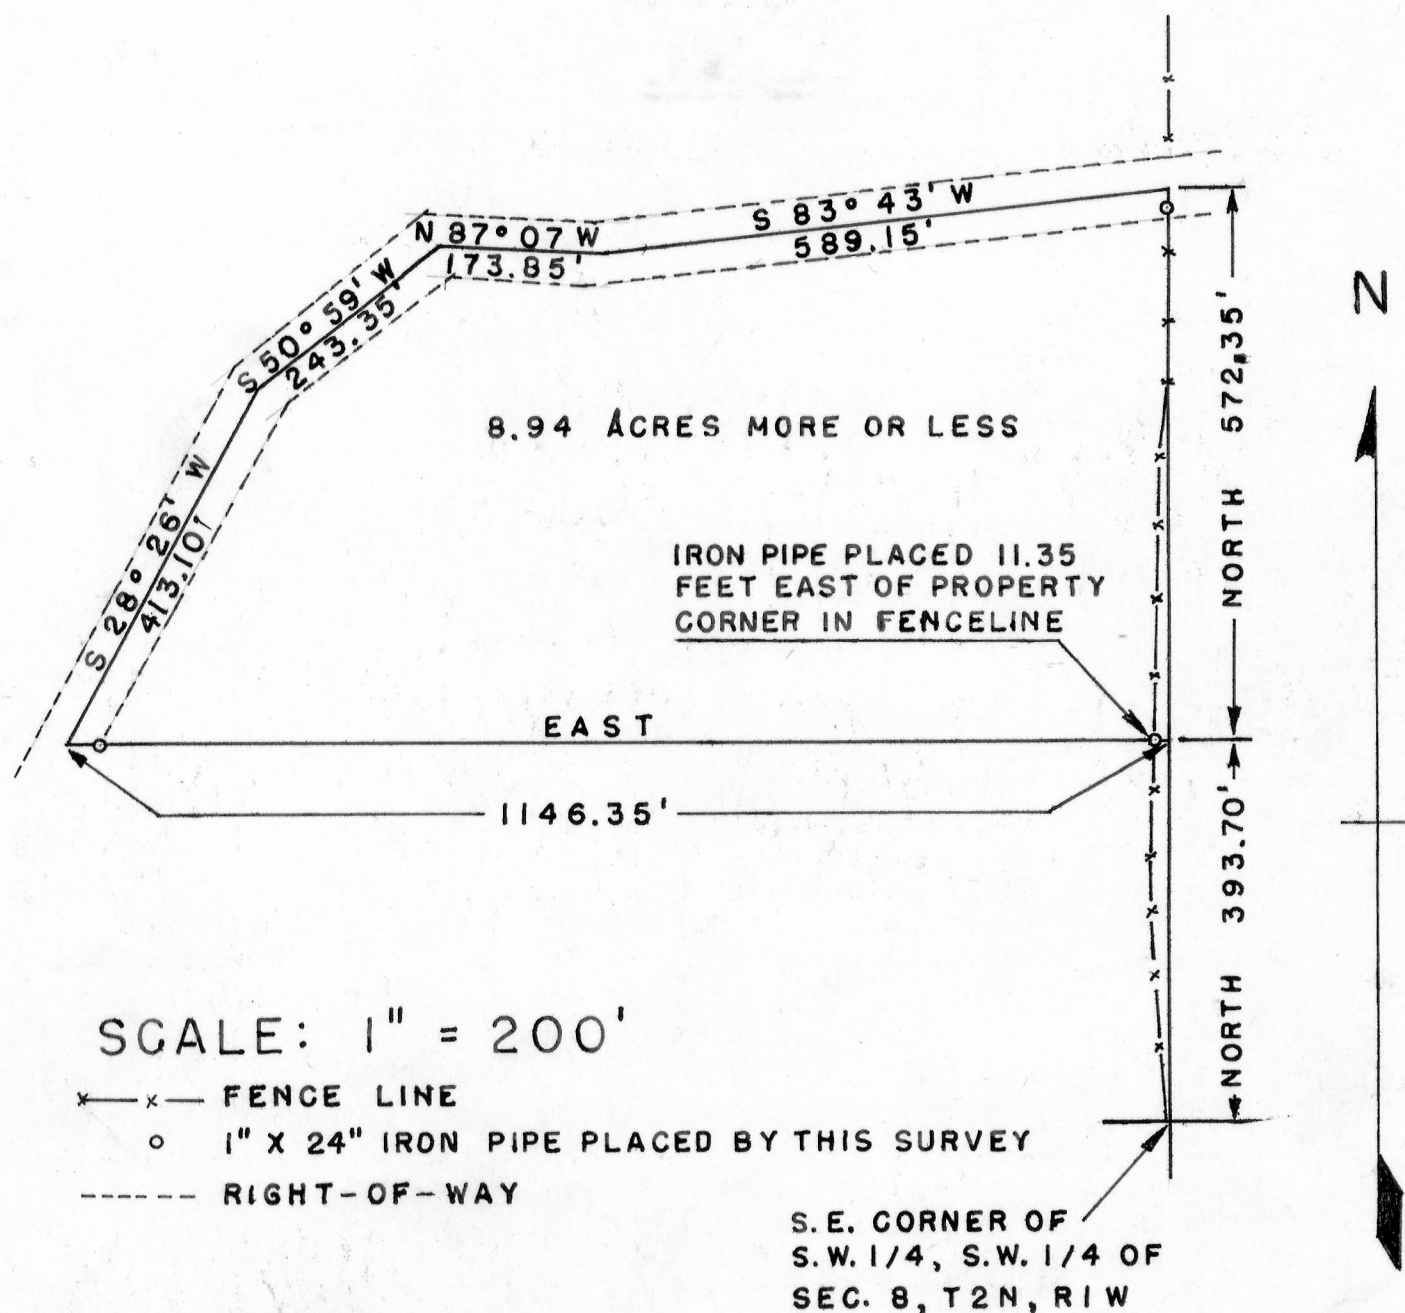

DESCRIPTION:

A part of the S.W.1/4 of the S.W.1/4 of Section 8, T 2 N, R 1 W, of the 4th P.M., Grant County, Wisconsin, described as follows to-wit: Begin at a point which is 393.70 feet North of the Southeast corner of the S.W.1/4 of the S.W.1/4 of said Section 8; thence North 572.35 feet to the centerline of town road; thence South 83° 43' West 589.15 feet along said centerline; thence North 87° 07' West 173.85 feet along said centerline; thence South 50° 59' West 243.35 feet along said centerline; thence South 28° 26' West 413.10 feet along said centerline; thence East 1146.35 feet to point of beginning. Containing 8.94 acres more or less inclusive of highway right-of-way.

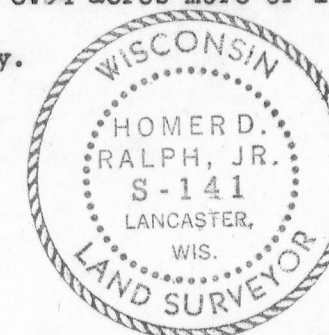

David Krohn
David Krohn
3/10/72 - 4/15/72

Homer D. Ralph, Jr.
Homer D. Ralph, Jr.
Surveyor for Grant
County, Wisconsin