



CLARENCE ALT SURVEY

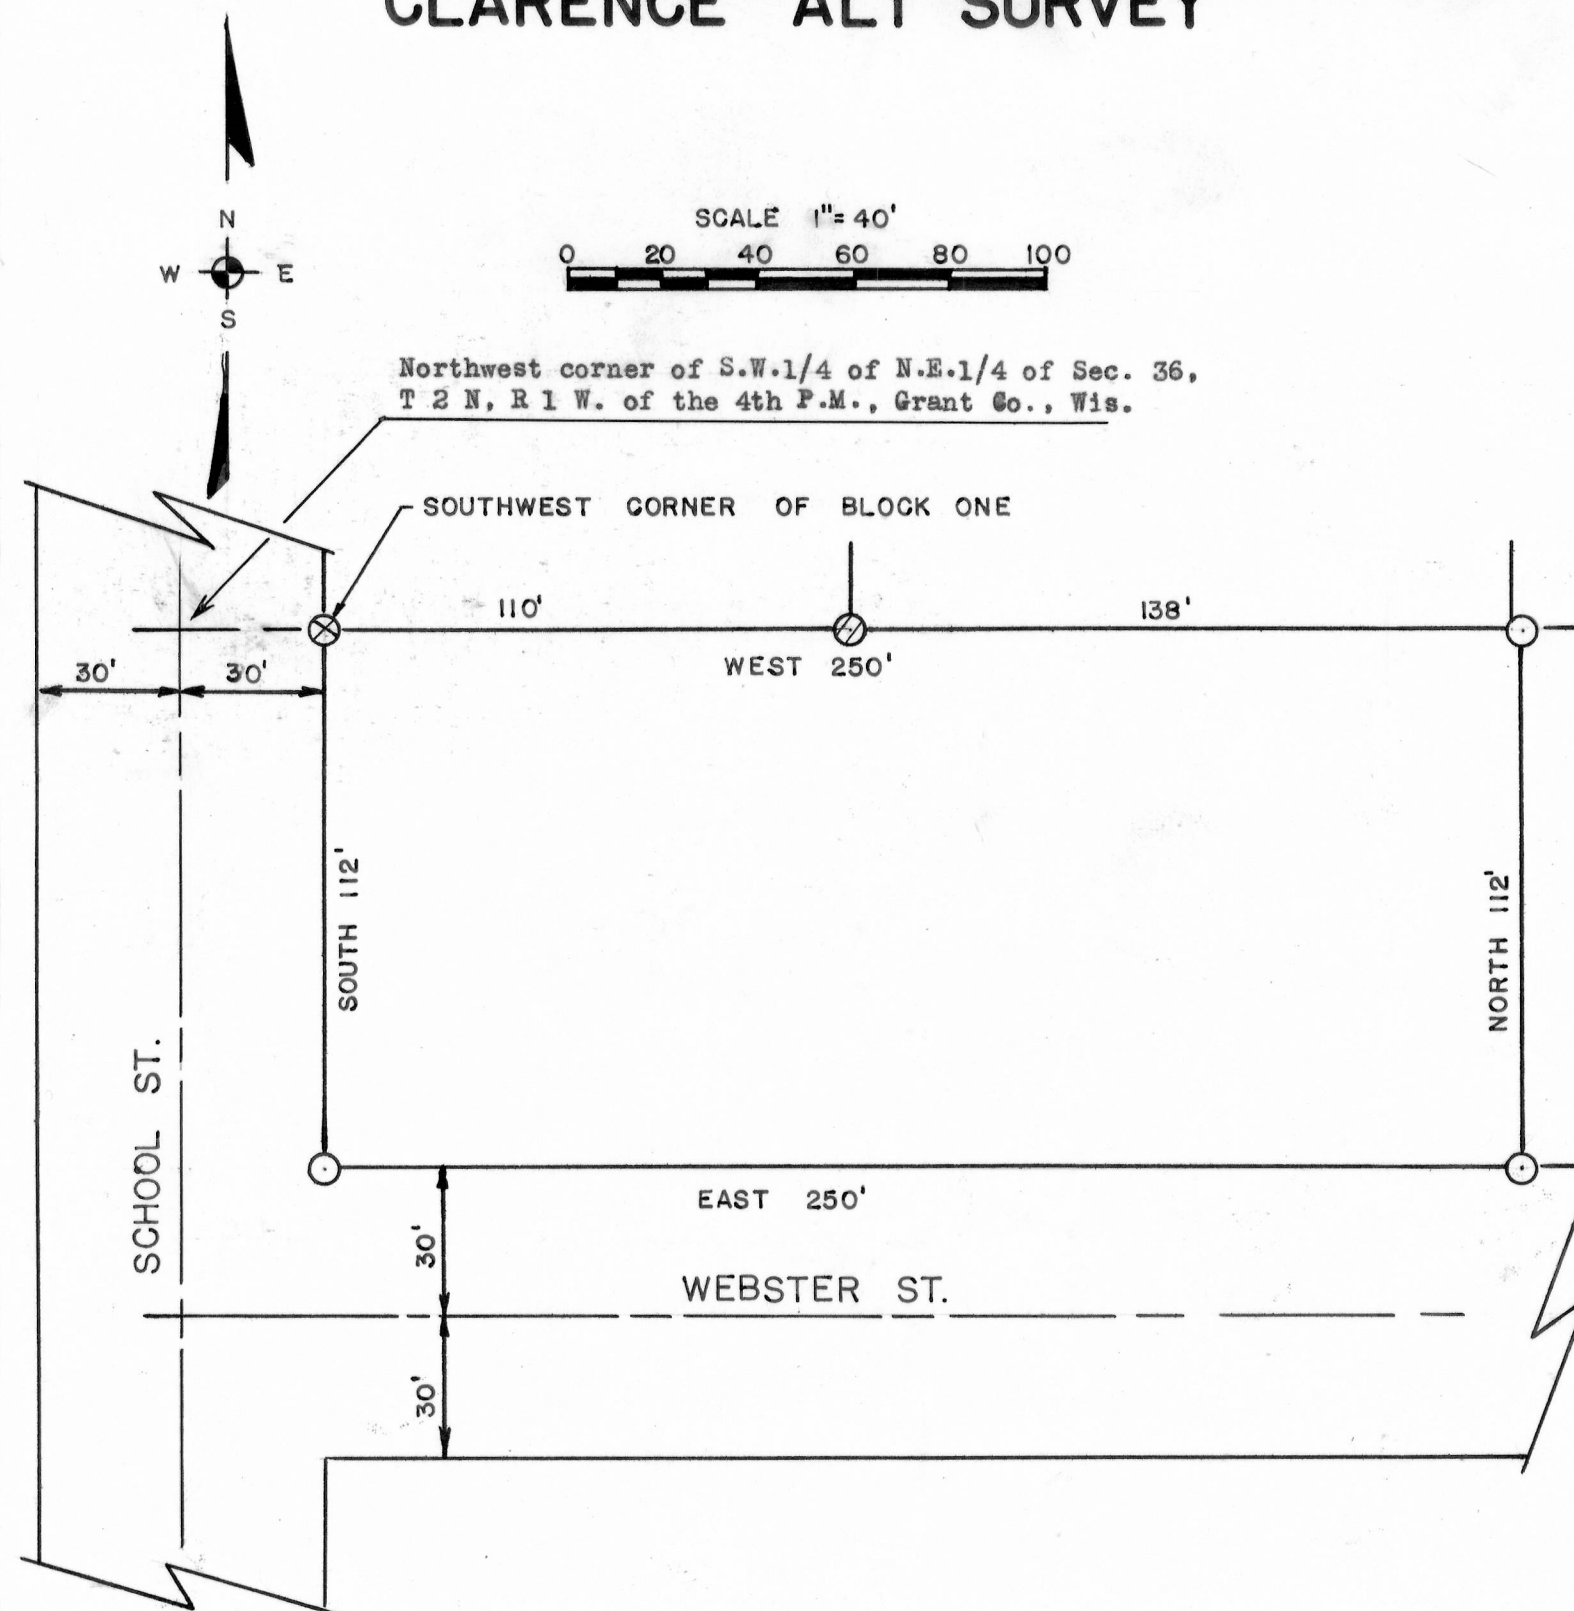

- ⊗ 2" X 30", 3.65 LBS./LIN.FT., IRON PIPE PLACED BY THIS SURVEY.
- 1" X 24", 1.13 LBS./LIN.FT., IRON PIPE PLACED BY THIS SURVEY.
- ⊗ 1" X 24", 1.13 LBS./LIN.FT., IRON PIPE PLACED BY PREVIOUS SURVEY.

DESCRIPTION:
COMMENCING AT THE SOUTHWEST CORNER OF BLOCK ONE, VAN DE WIEL
SUBDIVISION; A PART OF THE NE 1/4 OF SEC 36, T2N, R1W, OF THE 4TH
P.M.; IN THE CITY OF GUBA CITY, GRANT CO., WIS., TO WIT: THENCE
SOUTH 112 FEET, THENCE EAST 250 FEET, THENCE NORTH 112 FEET,
THENCE WEST 250 FEET TO THE POINT OF BEGINNING, CONTAINING
0.6 ACRES MORE OR LESS

Robert G. Anderson
ROBERT G. ANDERSON
3/25/69

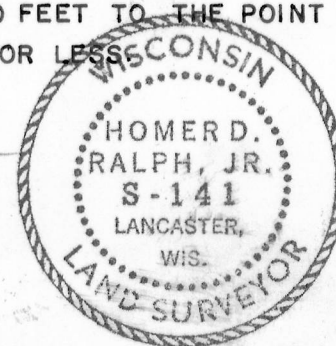

Homer D. Ralph, Jr.
HOMER D. RALPH, JR.
SURVEYOR FOR GRANT CO., WIS.
WIS. REG. NO. S-141