


HAUDENSHIELD SURVEY

SCALE 1" = 40'

N
S

Centerline of Clemens Street

Centerline of Madison Street

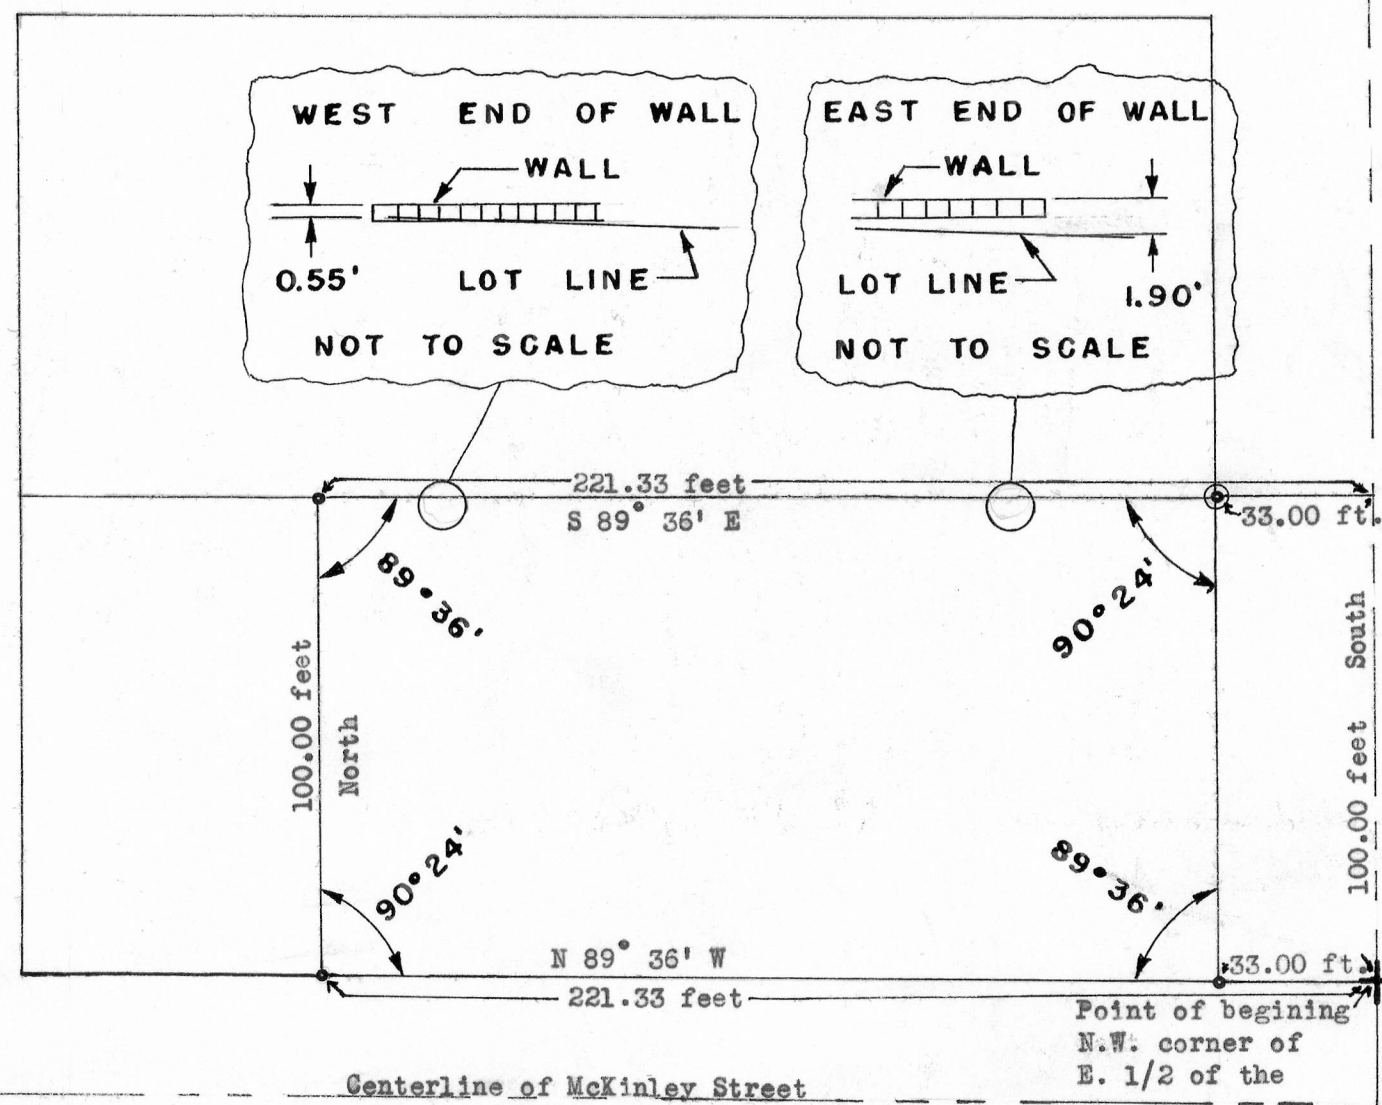

© P.K. NAIL PLACED BY THIS SURVEY

• - 1" X 24" Iron pipe placed by this survey.

DESCRIPTION:


Part of the S.W. 1/4 of the N.E. 1/4 of Section 36,

T 2 N, R 1 W, of the 4th P.M., Grant County, Wisconsin,

described as follows to-wit:

Begin at the Northwest Corner of the E. 1/2 of the S.E. 1/4 of said Section 36; thence North 89° 36' West 221.33 feet; thence North 100.00 feet; thence South 89° 36' East 221.33 feet to the Centerline of S.T.H. #80; thence South 100.00 feet along said centerline to the point of beginning.

Ralph Bourret
Ralph Bourret
10/25-11/2/73

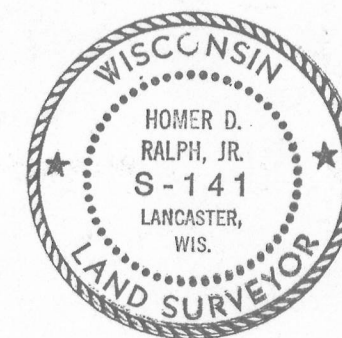

Homer D. Ralph, Jr.
Homer D. Ralph, Jr.
Surveyor for Grant
County, Wisconsin.