


D. JONES SURVEY

SCALE: 1" = 60'

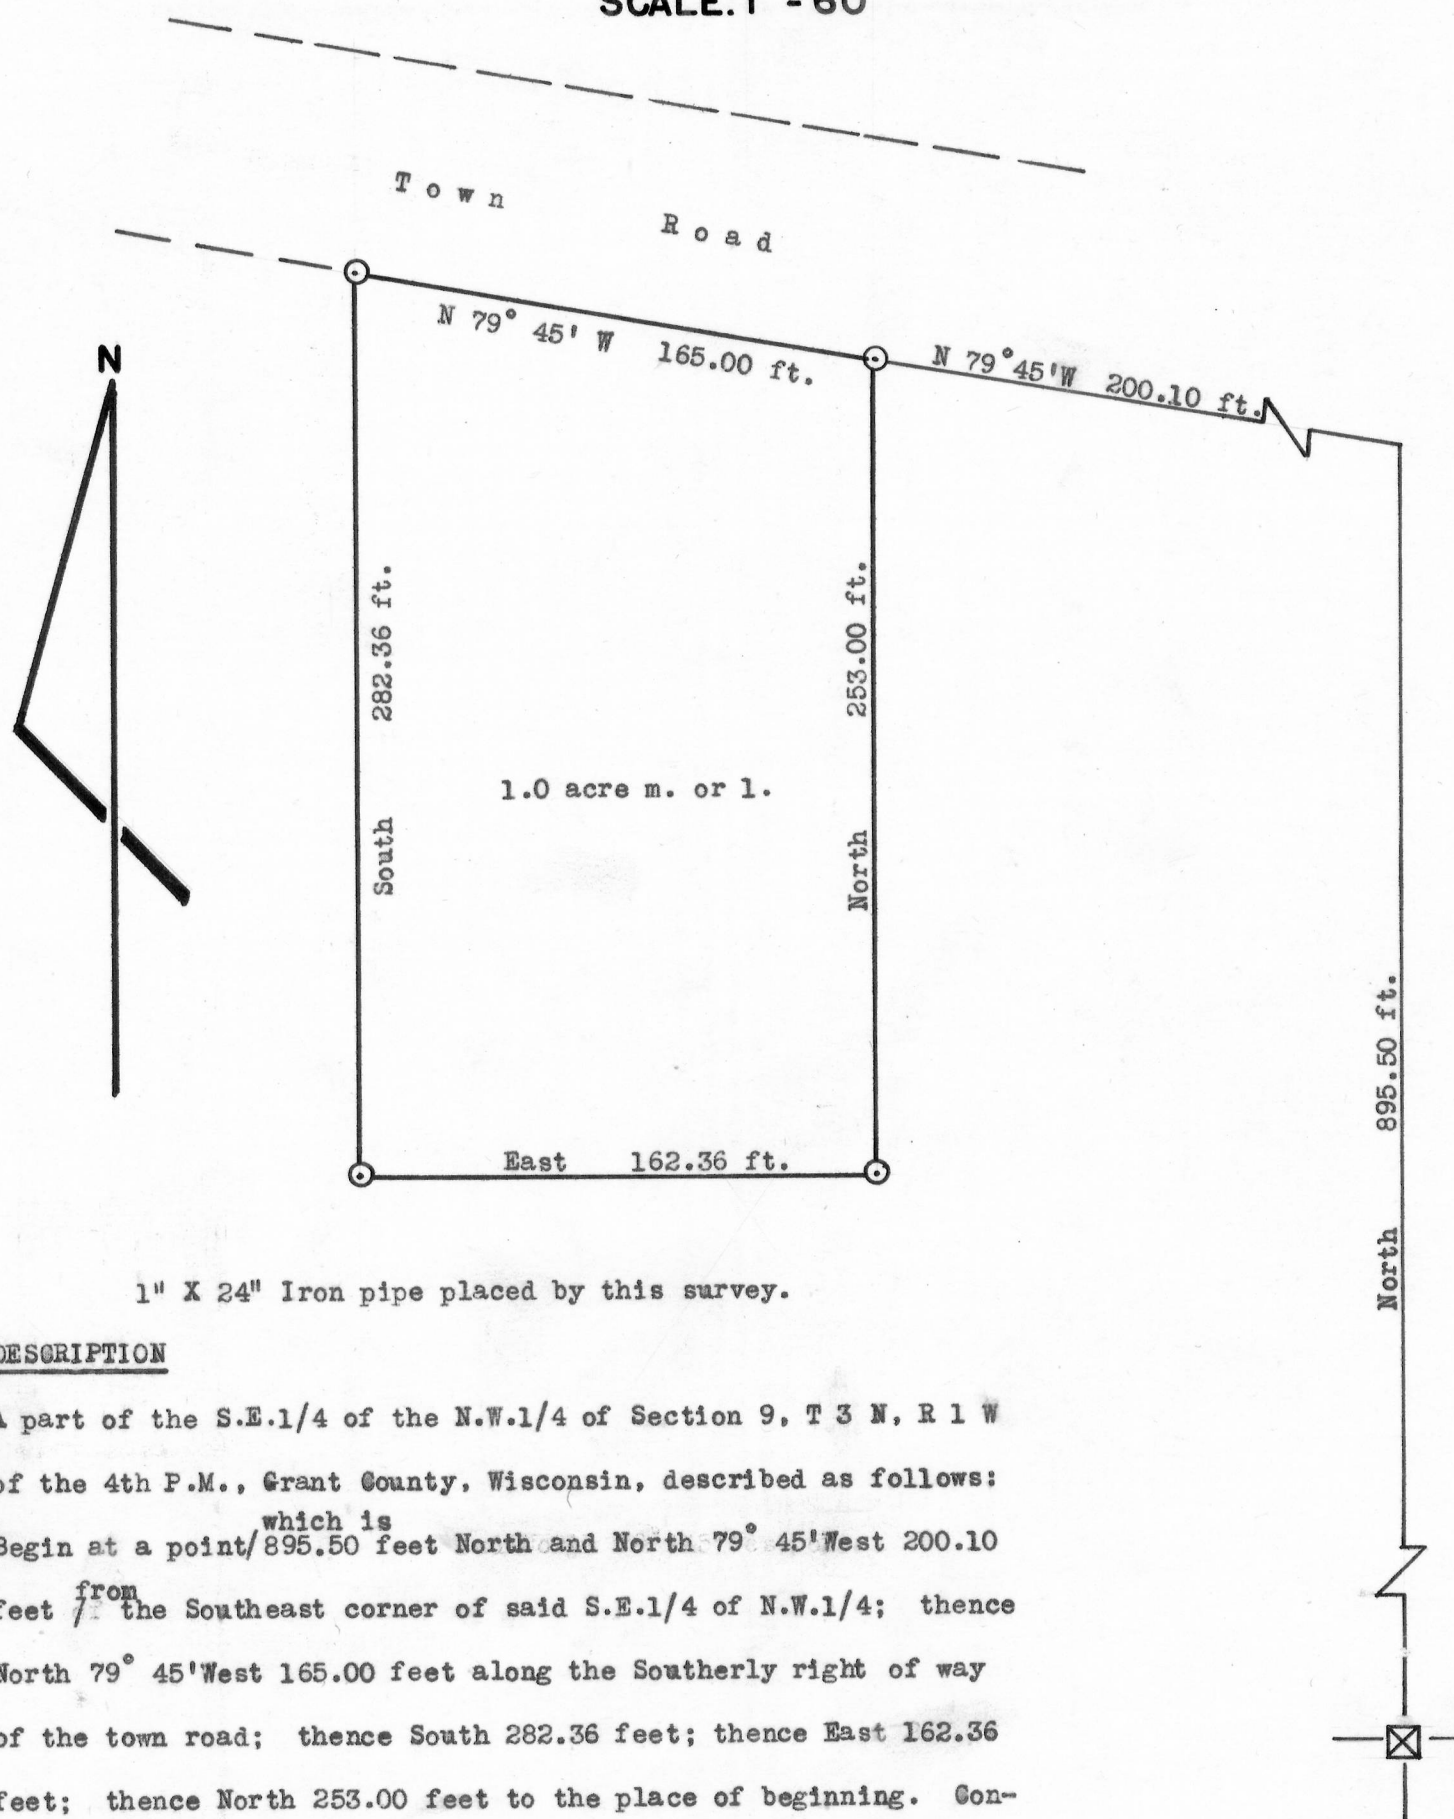

1" X 24" Iron pipe placed by this survey.

DESCRIPTION

A part of the S.E.1/4 of the N.W.1/4 of Section 9, T 3 N, R 1 W of the 4th P.M., Grant County, Wisconsin, described as follows:
 which is
 Begin at a point 895.50 feet North and North 79° 45' West 200.10 feet ^{from} the Southeast corner of said S.E.1/4 of N.W.1/4; thence North 79° 45' West 165.00 feet along the Southerly right of way of the town road; thence South 282.36 feet; thence East 162.36 feet; thence North 253.00 feet to the place of beginning. Containing 1.0 acres more or less.

Charles Lange
 Charles Lange
 6/10/71



Homer D. Ralph, Jr.
 Homer D. Ralph, Jr.
 Surveyor for Grant
 County, Wisconsin

Southeast corner,
 S.E.1/4, N.W.1/4,
 Section 9 -3-1
 (stone monument)